


WELL PLUGGING RECORD

Give All Information Completely
Make Required Affidavit
Mail or Deliver Report to:
Conservation Division
State Corporation Commission
211 No. Broadway
Wichita, Kansas

Thomas County, Sec. 36 Twp. 8S Rge. 32 ~~W~~ (W)

Location as "NE/CNW/SW" or footage from lines. C NE/4 SW/4
Lease Owner General Crude Oil Company
Lease Name C. J. Bremenkamp Well No. 1
Office Address 314 Commerce Bldg., Abilene, Texas
Character of Well (completed as Oil, Gas or Dry Hole) Dry Hole
Date well completed September 24, 19 58
Application for plugging filed Verbal Request September 23, 19 58
Application for plugging approved Verbal Approval September 23, 19 58
Plugging commenced September 23, 19 58
Plugging completed September 24, 19 58
Reason for abandonment of well or producing formation Nonproductive of oil or gas.

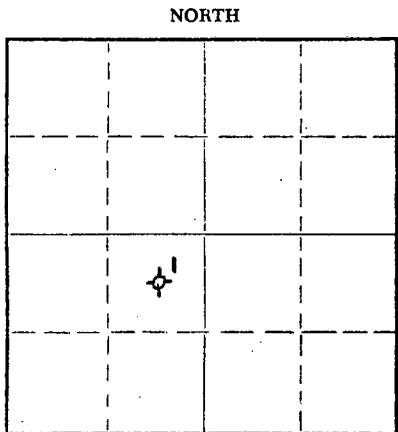

Locate well correctly on above Section Plat

If a producing well is abandoned, date of last production None 19
Was permission obtained from the Conservation Division or its agents before plugging was commenced? Yes - Mr. A. D. Fabricius in Hill City, Kansas

Name of Conservation Agent who supervised plugging of this well Mr. A. D. Fabricius
Producing formation None Depth to top - Bottom - Total Depth of Well 5305 Feet
Show depth and thickness of all water, oil and gas formations.

OIL, GAS OR WATER RECORDS

CASING RECORD

FORMATION	CONTENT	FROM	TO	SIZE	PUT IN	PULLED OUT
Sand	Water	100	290	8-5/8	416	None
Dakota		1508	1870		None	-
Topeka		3842	3890		None	-
Heebner		4042	4050		None	-
Lansing		4081	4205		None	-
Marmaton		4422	4495		None	-
Arbuckle		4968	5210		None	-
Reagan		5262	5305		None	-

Describe in detail the manner in which the well was plugged, indicating where the mud fluid was placed and the method or methods used in introducing it into the hole. If cement or other plugs were used, state the character of same and depth placed, from feet to feet for each plug set.

Heavy mud was circulated through open-ended drill pipe from 5305 to 600 feet. A 20 sack cement plug was mixed and pumped by Sun Cementing Company through the open-ended drill pipe suspended at 600 feet. The drill pipe was then pulled from the hole, leaving the plug from 540 to 600 feet. A wood plug was then placed in the 8-5/8 inch surface pipe and pushed to 420 feet. Another 20 sack plug was mixed and pumped by Sun Cementing Company through the open-ended drill pipe suspended at 418 feet. The pipe was then pulled from the hole, leaving the plug from 360 to 420 feet. Another wood plug was then pushed to 40 feet and 10 sacks of cement were mixed and pumped by Sun Cementing Company through the open-ended drill pipe suspended at 40 feet. The pipe was then pulled from the hole and the plug extended from 0 to 40 feet. A steel plate was welded over the 8-5/8 inch surface pipe which was at the bottom of a cellar 6 feet deep.

RECEIVED
STATE CORPORATION COMMISSION

OCT 10 1958


(If additional description is necessary, use BACK of this sheet)
Name of Plugging Contractor Sun Cementing Company
Address Hill City, Kansas

CONSERVATION DIVISION
Wichita, Kansas

STATE OF Texas, COUNTY OF Taylor, ss.
F. A. Hunter (employee of owner) or (owner or operator) of the above-described well, being first duly sworn on oath, says: That I have knowledge of the facts, statements, and matters herein contained and the log of the above-described well as filed and that the same are true and correct. So help me God.

(Signature) F. A. Hunter F. A. Hunter
314 Commerce Building, Abilene, Texas
(Address)

SUBSCRIBED AND SWORN to before me this 6th day of October, 19 58
My commission expires June 1, 1959.
Martha Wishert Martha Wishert
Notary Public.

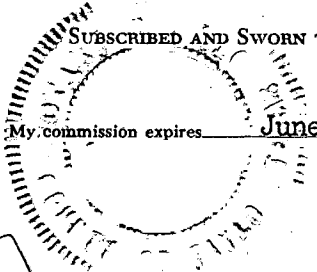

PLUGGING
FILE SEC 36 T. 8 R32W
BOOK PAGE 134 LINE 20

15-193-00003-00-00

GENERAL CRUDE OIL COMPANY
Center of NE $\frac{1}{4}$ of SW $\frac{1}{4}$, Section 36, T-*S, R-32W
Thomas County, Kansas

C.J. BREMENKAMP NO. 1

<u>FROM</u>	<u>TO</u>	<u>FORMATION</u>	<u>REMARKS</u>
0	40	Surface Clay	
40	290	Sand & Shale	
290	320	Shale	
320	424	Blue Shale	Ran 14 jts of 8-5/8" casing, set at 424' with 300 sacks cement.
424	1000	Shale	
1000	1580	Shale & shells	
1580	1820	Sand	
1820	1980	Sand & lime streaks	
1980	2295	Sand & shale	
2295	2355	Sand & anahydrate	
2355	2532	Red bed & shale	
2532	2670	Shale	
2670	2935	Lime & Shale	
2935	3100	Red bed & Shale	
3100	3230	Shale & Dolomite	
3230	3350	Shale & Shell	
3350	3505	Shale & lime	
3505	3568	Lime	
3568	3603	Lime & shale streaks	
3603	3662	Lime & sandy shale	
3662	3725	Lime	
3725	3825	Shale & lime	
3825	4078	Lime	
4078	4143	Lime & shale	
4143	4628	Lime	
4628	4663	Chert	
4663	4820	Lime & chert	
4820	4844	Chert	
4844	4860	Lime	
4860	4880	Lime & chert	
4880	4965	Lime	
4965	4985	Viola (Dolomite)	
4985	5259	Lime	
5259	5305	Lime & sand T.D.	Dry hole

I certify the above to be a true and exact copy of the Driller's Log as shown by the Daily Drilling Reports.

BADGER DRILLERS, INCORPORATED

Subscribed and sworn to before me this 2nd day of October, 1958.

Notary Public Martha Maher

My commission expires 6-26-60

PLUGGING			
FILE	SEC 36	T. 8	R32.W
BOOK	PAGE 134	LINE 28	