


WELL PLUGGING RECORD

Give All Information Completely
Make Required Affidavit
Mail or Deliver Report to:
Conservation Division
State Corporation Commission
800 Bitting Building
Wichita, Kansas

Sedgwick County, Sec. 13 Twp. 25S Rge. 1 (E) (W)

Location as "NE/CNW/SW" or footage from lines SW/4 SW/4 NW/4
Lease Owner Charles Carlock SE (ANS KCC)
Lease Name Tjaden Well No. 1
Office Address 102 Insurance Building, Wichita, Kansas
Character of Well (completed as Oil, Gas or Dry Hole) Dry Hole
Date well completed September 24, 1954 19
Application for plugging filed October 17, 1954 19
Application for plugging approved October 17, 1954 19
Plugging commenced October 17, 1954 19
Plugging completed October 17, 1954 19
Reason for abandonment of well or producing formation _____

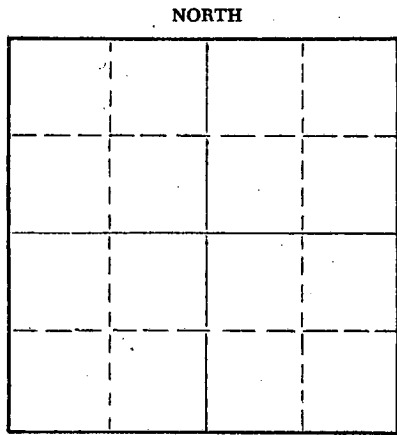

Locate well correctly on above Section Plat

If a producing well is abandoned, date of last production _____ 19
Was permission obtained from the Conservation Division or its agents before plugging was commenced? Yes

Name of Conservation Agent who supervised plugging of this well D. C. Lilley
Producing formation Burgess Depth to top 2912 Bottom 2918 Total Depth of Well 2918 Feet
Show depth and thickness of all water, oil and gas formations.

OIL, GAS OR WATER RECORDS

CASING RECORD

FORMATION	CONTENT	FROM	TO	SIZE	PUT IN	PULLED OUT
				8-5/8"	105	
				5-1/2"	2912	2540

Describe in detail the manner in which the well was plugged, indicating where the mud fluid was placed and the method or methods used in introducing it into the hole. If cement or other plugs were used, state the character of same and depth placed, from _____ feet to _____ feet for each plug set.

Filled bottom of hole with 6 feet of sand from 2918 feet to 2912 feet. Dumped 2 sacks of cement. Filled hole with heavy mud to 175 feet. Set bridge at 175 feet and dumped 10 sacks of cement. Filled hole with heavy rotary mud to 10 feet and cement to base of cellar.

(If additional description is necessary, use BACK of this sheet)




Name of Plugging Contractor LOWELL URIE (RICHARDS & DUFFENS)
Address 831 Kansas Ave., Topeka, Kansas

STATE OF KANSAS, COUNTY OF SEDGWICK, ss.
I, Charles Carlock (employee of owner) or (owner or operator) of the above-described well, being first duly sworn on oath, says: That I have knowledge of the facts, statements, and matters herein contained and the log of the above-described well as filed and that the same are true and correct. So help me God.

(Signature) Charles James Carlock
102 Insurance Bldg., Wichita, Kansas (Address)

SUBSCRIBED AND SWORN TO before me this 10th day of November, 19 54
Sevan S. Greuter Notary Public.

My commission expires January 31, 1957

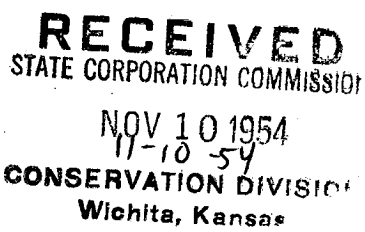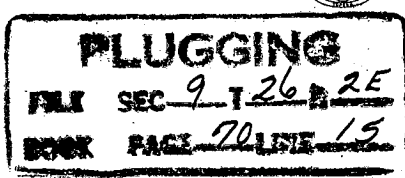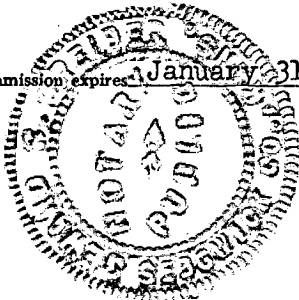

WELL LOG - TJADEN #1

OPERATOR: Mr. Charles Carlock
102 Insurance Building
Wichita, Kansas

(ANS REC) SE
LOCATION: SW/4 SW/4 NW/4
Section 13-25-1E
Sedgwick County, Kansas

CONTRACTOR: Morrison Drilling Company, Inc.
Drawer 712
El Dorado, Kansas

PRODUCTION: _____

Farm - Tjaden Well #1
Date Commenced: 9-19-54
Date Completed: 9-24-54

Total Depth: 2916' - Rotary

From	To	Formation
75	103	Cement
103	123	Lime
123	158	Shale and lime streaks
158	270	Lime
270	325	Shale and lime streaks
325	375	Shale and lime
375	390	Lime
390	585	Shale and lime streaks
585	610	Lime and shale
610	615	Red Bed
615	710	Lime and shale
710	835	Shale and lime
835	1235	Lime and shale streaks
1235	1670	Lime and shale
1670	1905	Shale and lime
1905	2274	Lime and shale
2274	2466	Lime
2466	2552	Lime and shale
2552	2609	Lime
2609	2698	Lime and shale
2698	2768	Shale and lime
2768	2798	Shale
2798	2912	Lime and shale
2912	2916	Sand
2916		Total Depth

I hereby certify that the foregoing is a true and correct copy of the Well Log for the Tjaden #1 well drilled for Charles Carlock, and completed September 24, 1954.

MORRISON DRILLING COMPANY, INC.

C. W. Wilson - Secretary Treasurer

STATE OF KANSAS)
) ss:
COUNTY OF BUTLER)

SUBSCRIBED AND SWORN TO, Before the Undersigned, a Notary Public, in and for County and State aforesaid this 27th day of September, 1954.

C. W. Wilson
STATE CORPORATION COMMISSIONER
Notary Public

NOV 10 1954

CONSERVATION DIVISION
Wichita, Kansas

My Commission Expires January 10, 1955

PLUGGING

FILE SEC 9-126225
BOOK PAGE 20 LINE 15

