

STATE OF KANSAS
STATE CORPORATION COMMISSION

WELL PLUGGING RECORD

Give All Information Completely
Make Required Affidavit
Mail or Deliver Report to:
Conservation Division
State Corporation Commission
800 Bitting Building
Wichita, Kansas

Sedgwick

County. Sec. 9 Twp. 26 Rge. 2 (E) (W)

Location as "NE/CNW&SW" or footage from lines C S/2 N/2 NW/4

Lease Owner Mr. J. P. Gaty

Lease Name Broers "B" Well No. 1

Office Address c/o Beech Aircraft Corp., Wichita, Kansas

Character of Well (completed as Oil, Gas or Dry Hole) Dry Hole

Date well completed September 24 19 52

Application for plugging filed Verbal September 24 19 52

Application for plugging approved Verbal September 24 19 52


Plugging commenced September 24 19 52

Plugging completed September 24 19 52

Reason for abandonment of well or producing formation _____

If a producing well is abandoned, date of last production _____ 19 _____

Was permission obtained from the Conservation Division or its agents before plugging was commenced? Yes

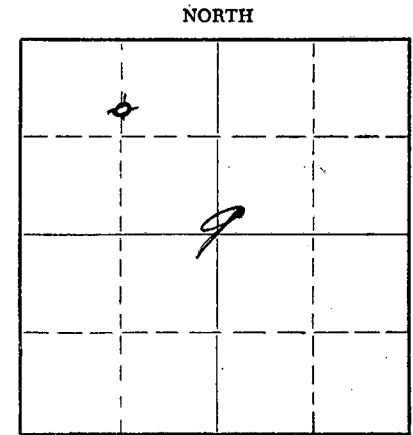

Locate well correctly on above
Section Plat

Name of Conservation Agent who supervised plugging of this well J. P. Roberts, Wichita, Kansas

Producing formation _____ Depth to top _____ Bottom _____ Total Depth of Well 2945 Feet

Show depth and thickness of all water, oil and gas formations.

OIL, GAS OR WATER RECORDS

CASING RECORD

FORMATION	CONTENT	FROM	TO	SIZE	PUT IN	PULLED OUT
				8 5/8"	113'	

Describe in detail the manner in which the well was plugged, indicating where the mud fluid was placed and the method or methods used in introducing it into the hole. If cement or other plugs were used, state the character of same and depth placed, from _____ feet to _____ feet for each plug set.

Filled hole with heavy rotary mud to bottom of surface and set wooden plug. Cemented w/12 sax cement. Filled hole with heavy rotary mud to within 6' of base of cellar and capped with 3 sax cement.

(If additional description is necessary, use BACK of this sheet)

Name of Plugging Contractor Morrison Drilling Company, Inc.
Address Drawer 712, El Dorado, Kansas

STATE OF KANSAS, COUNTY OF SEDGWICK, ss.
John P. Gaty (employee of owner) or (owner or operator) of the above-described well, being first duly sworn on oath, says: That I have knowledge of the facts, statements, and matters herein contained and the log of the above-described well as filed and that the same are true and correct. So help me God.

(Signature) John P. Gaty
11 Cypress Dr. Wichita, Kans. (Address)

SUBSCRIBED AND SWORN TO before me this 26th day of September, 1952
John D. Sand Notary Public.

My commission expires December 12, 1955
24-2675-5 2-52-20M

RECEIVED
STATE CORPORATION COMMISSION

PLUGGING
FILE SEC 9 T 26 R 2E
BOOK PAGE 47 LINE 7

SEP 30 1952
9-30-52
CONSERVATION DIVISION
Wichita, Kansas

WELL LOG - Broers B-1

OPERATOR: Mr. J. P. Gaty
c/o Beech Aircraft Corp.
Wichita, Kansas

LOCATION: C S/2 N/2 NW/4
Section 9-26-2E
Sedgwick County, Kansas

CONTRACTOR: Morrison Drilling Company, Inc.
P. O. Drawer 712
El Dorado, Kansas

PRODUCTION: D & A

Farm: Broers "B" Well No. 1

Date Commenced: September 18, 1952
Date Completed: September 24, 1952

Total Depth: 2945 - Rotary

From	To	Formation
0	40	Surface Clay
40	90	Shale & Lime
90	110	Lime - Surface
110	210	Lime
210	335	Shale & Lime
335	614	Lime & Shale brks.
614	622	Red Bed
622	705	Lime & Shale
705	900	Shale & Shells
900	1045	Lime & Shale
1045	1420	Shale
1420	1525	Shale & Lime strks.
1525	1628	Shale & Lime shells
1628	1730	Lime w/shale strks.
1730	2105	Lime & Shale
2105	2130	Shale w/lime strks.
2130	2164	Lime & Shale
2164	2211	Lime
2211	2337	Lime & Shale
2337	2475	Shale & Lime strks.
2475	2630	Lime
2630	2697	Lime
2697	2753	Shale & Shells
2753	2912	Shale & Lime
2912	2918	Sand & Shale
2918	2936	Shale & Shells
2936	2938	Burgess Sand
2938	2943	White Shale - hard
2943	2945	Chert
2945		Total Depth.


I hereby certify that the foregoing is a true and correct copy of the Well Log for the #1 - Broers "B" well drilled for Mr. J. P. Gaty and completed September 24, 1952.

MORRISON DRILLING COMPANY, INC.

C. W. Wilson - Secretary-Treasurer

STATE OF KANSAS)
) ss.
COUNTY OF BUTLER)

SUBSCRIBED AND SWORN TO, Before the Undersigned, a Notary Public, in and for the County and State aforesaid this 26th day of September, 1952.

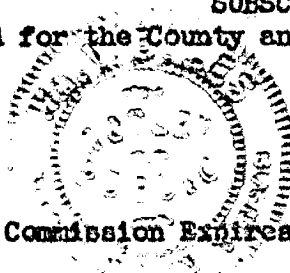

STATE OF KANSAS COMMISSION
SEP 30 1952
CONSERVATION DIVISION
Notary Public Kansas

My Commission Expires January 10, 1955.

PLUGGING
FILE SEC 9 T 26 R 2 E
BOOK PAGE 47 LINE 7