

15-173-01990-00-01

We also need a well log on this well

Form CP-4

STATE OF KANSAS
STATE CORPORATION COMMISSION

Give All Information Completely
Make Required Affidavit
Mail or Deliver Report to:
Conservation Division
State Corporation Commission
211 No. Broadway
Wichita, Kansas

WELL PLUGGING RECORD

Sedgwick County, Sec. 11 Twp. 26 Rge. 2E (E) ~~(W)~~

Location as "NE/CNW/SW" or footage from lines NE NW SE

Lease Owner Warren R. Winnie Oil Company,

Lease Name Weiskirch Weiskirch AUB Well No. 1

Office Address 5503 E. Kellogg - Wichita, Kansas.

Character of Well (completed as Oil, Gas or Dry Hole) D&A

Date well completed 2/1/61 19

Application for plugging filed 2/1/61 19

Application for plugging approved 2/1/61 19


Plugging commenced 2/1/61 19

Plugging completed 2/1/61 19

Reason for abandonment of well or producing formation

If a producing well is abandoned, date of last production 19

Was permission obtained from the Conservation Division or its agents before plugging was commenced? Yes

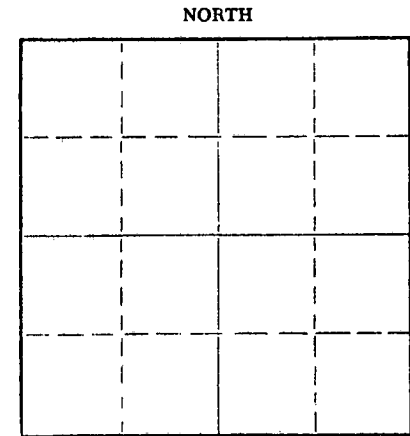

Locate well correctly on above Section Plat

Name of Conservation Agent who supervised plugging of this well Lee Guthrie

Producing formation Depth to top Bottom Total Depth of Well 2913' Feet

Show depth and thickness of all water, oil and gas formations.

OIL, GAS OR WATER RECORDS

CASING RECORD

FORMATION	CONTENT	FROM	TO	SIZE	PUT IN	PULLED OUT

Describe in detail the manner in which the well was plugged, indicating where the mud fluid was placed and the method or methods used in introducing it into the hole. If cement or other plugs were used, state the character of same and depth placed, from feet to feet for each plug set.

200' 8 5/8" surface pipe - Cement circulated, 2910' 1 1/2"
Pipe set with 75 sacks cement, top Perforation at 2875'
hole filled to 2870' with gravel and 3 sacks cement
at 200' set 20' rock Bridge and 15 sacks cement - mud
to 25' set 10 R.B. & 5 sacks cement. Recovered 2300' 1 1/2"
pipe.

RECEIVED
STATE CORPORATION COMMISSION

SEP 17 1963

9-17-63

CONSERVATION DIVISION
Wichita, Kansas

(If additional description is necessary, use BACK of this sheet)

Name of Plugging Contractor B. & G. Well Service
Address Winfield, Kansas.

STATE OF Kansas COUNTY OF Sedgwick, ss.

(employee of owner) or (owner or operator) of the above-described well, being first duly sworn on oath, says: That I have knowledge of the facts, statements, and matters herein contained and the log of the above-described well as filed and that the same are true and correct. So help me God.

(Signature) Warren R. Winnie

5503 E. Kellogg (Address)

September 17, 1963

Margaret Hates Notary Public.

Subscribed and sworn to before me this 13 day of September, 1963
6-14-64
My commission expires



WELL LOG BUREAU—KANSAS GEOLOGICAL SOCIETY
508 East Murdock, Wichita, Kansas


COPY
P

Company- MURFIN DRILG. CO.
Farm- Weiskirch No. 10

SEC. 11 T. 26 R. 2E
NE NW SE

Total Depth. 2910'
Comm. 5-4-59 Comp. 5-10-59
Shot or Treated.
Contractor. Murfin Drilg. Co.
Issued. 7-11-59

County Sedgwick
KANSAS

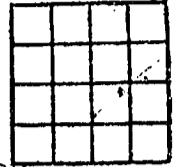

CASING:
8 5/8" 156' w/110 sx cem.

Elevation. 1360' DP

Production. DRY

Figures Indicate Bottom of Formations.

shale	60
lime, gyp	154
lime, shale	430
lime	580
shale, lime	720
shale, shells	1140
lime, shale	2500
lime	2567
shale, lime	2815
lime	2910
Total Depth	

TOPS: Geol.	
Lansing	2185
Kansas City lime	2392
B/Kansas City	2559
Mississippi lime	2845
Chat	2878

DST #1 - 2845-60 Open 30 mins.
Weak blow 5 min. Rec. 5' mud
w/scum of heavy blk oil. BHP
120#/20 min. IF 0%, FF 20%.

DST #2 2876-84 Open 1 1/2 hrs.
Medium blow. Rec. 150' gas,
30' muddy oil, 60' oil cut
wtr. IF 20%. FF 140%. BHP 440#.
30 min..

DST #3 2878 - 2910 Open 45 min.
Strong blow. Rec. 150' gas, 30'
OCM, 900' slightly oil & gas cut
salt wtr. IF 130%, FF 435#. BHP
460#/20 min.