


STATE OF KANSAS
STATE CORPORATION COMMISSION

WELL PLUGGING RECORD

Give All Information Completely
Make Required Affidavit
Mail or Deliver Report to
Conservation Division
State Corporation Comm.
245 North Water
Wichita, KS 67202

Sedgwick County. Sec. 11 Twp. 26 Rge. 2E E/W
Location as "NE/CNW 1/4 SW 1/4" or footage from lines
1200' NFS Line 420' WFE Line
Lease Owner Marshall Oil Company
Lease Name Burge Well No. 2
Office Address Box 306, Eureka, Kansas 67045
Character of Well (Completed as Oil, Gas or Dry Hole) Dry

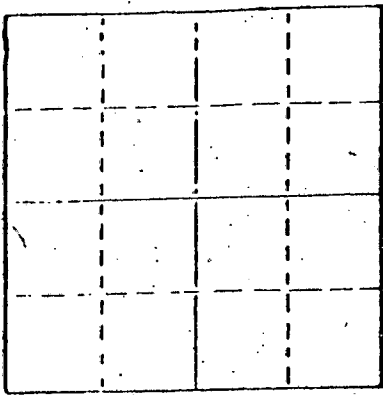

Date Well completed 10/10 1981
Application for plugging filed 10/10 1981
Application for plugging approved 10/10 1981
Plugging commenced 10/10 1981
Plugging completed 10/10 1981
Reason for abandonment of well or producing formation _____

If a producing well is abandoned, date of last production 19

Was permission obtained from the Conservation Division or its agents before plugging was commenced? Yes

Name of Conservation Agent who supervised plugging of this well Don Thompson
Producing formation _____ Depth to top _____ Bottom _____ Total Depth of Well 3197'
Show depth and thickness of all water, oil and gas formations.

OIL, GAS OR WATER RECORDS

CASING RECORD

FORMATION	CONTENT	FROM	TO	SIZE	PUT IN	PULLED OUT
	Surface	0	200'	8"	200'	0

Describe in detail the manner in which the well was plugged, indicating where the mud fluid was placed and the method or methods used in introducing it into the hold. If cement or other plugs were used, state the character of same and depth placed, from _____ feet to _____ feet for each plug set.

Mud up to 220' Plug 1/2 Sack Hulls 30 Sacks Cement
Mud up to 40' Plug 1/2 Sack Hulls 12 Sacks Cement
5 Sacks Cement In Rathole

RECEIVED
STATE CORPORATION COMMISSION
10-30-81
OCT 30 1981

(If additional description is necessary, use BACK of this sheet)
Name of Plugging Contractor EDCO Drilling Company, Inc.

CONSERVATION DIVISION
Wichita, Kansas

STATE OF Kansas COUNTY OF Butler, ss.
(employee of owner) or (owner or operator)
of the above-described well, being first duly sworn on oath, says: That I have knowledge of the facts, statements, and matters herein contained and the log of the above-described well as filed and that the same are true and correct. So help me God.


(Signature) W.K. Gindlgraber
Box 645, El Dorado, KS 67042
(Address)

SUBSCRIBED AND SWORN TO before me this 27th day of October, 1981

DARLENE L. BRUNER
Statewide Notary Public
Butler County, Kansas
My Appt. Exp. 8-27-83

Darlene L. Bruner
Notary Public

My commission expires

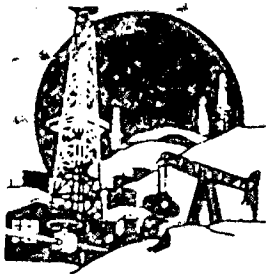

EDCO Drilling Company, Inc.

124 WEST LOCUST — P.O. BOX 645 — EL DORADO, KANSAS 67042

October 23, 1981

To: Marshall Oil Company
Box 306
Eureka, Kansas 67045

Lease: Burge #2

LOCATION: Sec. 11, Twp. 26, Rge. 2E
Sedgwick County

Drilling
Dates: October 5 thru October 10, 1981

Drilling Log

435'	Shale w/Lime Streaks
1035'	Shale
1315'	Shale w/Lime Streaks
1716'	Shale w/Lime Streaks
2100'	Shale w/Lime Streaks
2310'	Shale w/Lime Streaks
2626'	Shale w/Lime streaks
2800'	Shale w/Lime Streaks
2835'	Shale
2881'	Mississippi Lime
2924'	Mississippi
3040'	Mississippi
3131'	Mississippi
3144'	Mississippi
3192'	Kinderhook
3197'	Hunton T.D.

RECEIVED
STATE CORPORATION COMMISSION

OCT 30 1981

CONSERVATION DIVISION
Wichita, Kansas