

15-173-00793-00-00

WELL PLUGGING RECORD


STATE OF KANSAS
STATE CORPORATION COMMISSION

FORMATION PLUGGING RECORD

Give All Information Completely
Make Required Affidavit
Mail or Deliver Report to:
Conservation Division
State Corporation Commission
800 Bittling Building
Wichita, Kansas

Strike out upper line
when reporting plug-
ging off formations.

Sedgwick County. Sec. 11 Twp. 26S Rge. 2 (E) (W)
Location as "NE 1/4 NW 1/4 SW 1/4" or footage from lines SW NE SW
Lease Owner. SHELL OIL COMPANY, INC.
Lease Name. H. Stollei Well No. 1
Office Address. Box 650, McPherson, Kansas
Character of Well (completed as Oil, Gas or Dry Hole) Oil Well
Date well completed. 2 19 30
Application for plugging filed. 4- 8 19 48
Application for plugging approved. 4- 9 19 48
Plugging commenced. 4-17 19 48
Plugging completed. 5- 3 19 48
Reason for abandonment of well or producing formation well depleted

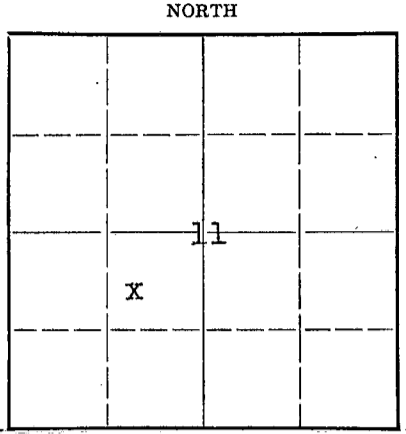

Locate well correctly on above
Section Plat

If a producing well is abandoned, date of last production. 5 19 45
Was permission obtained from the Conservation Division or its agents before plugging was commenced? Yes

Name of Conservation Agent who supervised plugging of this well. Ruel Durkee
Producing formation. Viola Depth to top 3165' Bottom. Total Depth of Well 3168 Feet
Show depth and thickness of all water, oil and gas formations.


OIL, GAS OR WATER RECORDS

CASING RECORD

Formation	Content	From	To	Size	Put In	Pulled Out
Viola	oil & wtr	3165	3168	15 1/2	114'	Left in hole
				8-5/8	2804'	Rec. 2164'
				7	3074'	Rec. 2794'
				5-3/16	3165'	Rec. 3076'

Describe in detail the manner in which the well was plugged, indicating where the mud fluid was placed and the method or methods used in introducing it into the hold. If cement or other plugs were used, state the character of same and depth placed, from.....feet to.....feet for each plug set.

3168' To 3118' PB W/Cement
3118' 150' PB W/Mud
150' 30' PB W/Rock
30' 10' PB W/Mud
10' 0' Capped W/5 Sacks Cement

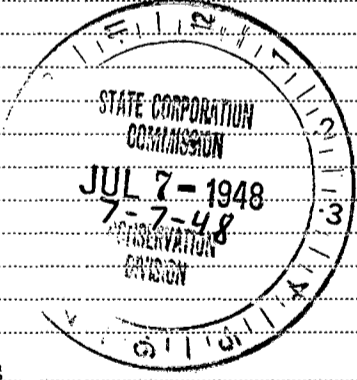

(If additional description is necessary, use BACK of this sheet)

Correspondence regarding this well should be addressed to. R. M. Fruits
Address. Box 650, McPherson, Kansas

STATE OF Kansas, COUNTY OF McPherson, ss.
R. M. Fruits (employee of owner) or (owner or operator) of the above-described well,
being first duly sworn on oath, says: That I have knowledge of the facts, statements, and matters herein contained and the log of the above-described well as filed and that the same are true and correct. So help me God.

(Signature) R. M. Fruits
Box 650, McPherson, Kansas
(Address)

SUBSCRIBED AND SWORN to before me this 2nd day of July, 19 48.
5-7-51
Notary Public.



PLUGGING
FILE SEC. 11 T 26 R 2E
BOOK PAGE 21 LINE 9

WELL LOG

WELL: H. Stollei No. 1
• LOC.: SW NE SW, 11-26S-2E

CASING RECORD

15 $\frac{1}{8}$ " Cemented at 114'; 8-5/8" Cemented at 2804'; 7" Set at 3074'; 5-3/16" Set at 3165'.

0 85 Surface
114 Lime
173 Broken lime-shale
220 Water sand-shell
239 Broken lime
410 Shale-shell
430 Broken lime
510 Shale-shell
760 Broken lime shell-shale
805 Shale
835 Broken lime
1057 Shale-shell
1147 Broken lime-shale
1252 Shale-limeshell
1432 Shale
1820 Shale-shell
1904 Broken lime-shale
1930 Shale
1945 Broken lime
2042 Shale
2082 Shale-shell
2092 Broken lime
2148 Shale-shell
2152 Lime
2180 Broken lime
2260 Shale
2315 Shale-Broken lime
2374 Shale-shell
2400 Broken lime
2473 Shale
2503 Shale-shell
2540 Broken lime
2555 Shale-lime
2623 Shale-shell
2702 Shale
2792 Limeshell
2814 Lime
2822 Shale
2825 Lime
2832 Variegated shell & shale
2833 Lime
2859 Variegated shale
2861 Lime
2863 Lime-green shale
2870 Green shale-brown chert
2900 Chat SLM
2917 Lime-chat
2940 Lime
2964 Chat
3118 Lime
3165 Shale
3168 Lime TOTAL DEPTH

COMPLETED: FEBRUARY, 1930

DISTRICT: Greenwich

COUNTY: Sedgwick

STATE: Kansas

APR - 9 1948

PLUGGING
FILE SEC-11 T-26R2E
BOOK PAGE 21 LINE 9