

STATE OF KANSAS
STATE CORPORATION COMMISSION

Form CP-4


Give All Information Completely
Make Required Affidavit
Mail or Deliver Report to:
Conservation Division
State Corporation Commission
211 No. Broadway
Wichita, Kansas

WELL PLUGGING RECORD

Sedgwick County, Sec. 11 Twp. 26S Rge. 2 (E) 1/W1

Location as "NE/CNW/SW" or footage from lines. SW SE SE
Lease Owner Muffin Drilling Co.
Lease Name Weiskirch Well No. 5
Office Address 617 Union Center
Character of Well (completed as Oil, Gas or Dry Hole) SWD
Date well completed _____ 19____
Application for plugging filed 11-23 1962
Application for plugging approved 11-26 1962
Plugging commenced 12-08 1962
Plugging completed 12-12 1962
Reason for abandonment of well or producing formation abandoning lease

NORTH

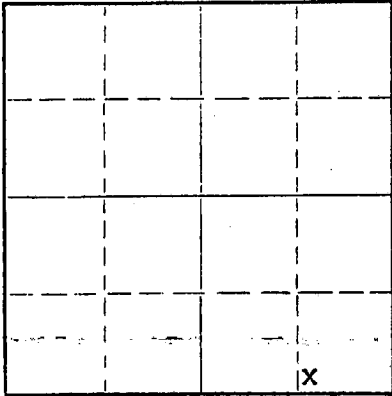

Locate well correctly on above
Section Plat

If a producing well is abandoned, date of last production _____ 19____
Was permission obtained from the Conservation Division or its agents before plugging was commenced? yes

Name of Conservation Agent who supervised plugging of this well Paul Turpin
Producing formation _____ Depth to top _____ Bottom _____ Total Depth of Well 4011 Feet
Show depth and thickness of all water, oil and gas formations.

OIL, GAS OR WATER RECORDS

CASING RECORD

FORMATION	CONTENT	FROM	TO	SIZE	PUT IN	PULLED OUT
				8 5/8	82	cemented
				4 1/2	3385	2350, 94

Describe in detail the manner in which the well was plugged, indicating where the mud fluid was placed and the method or methods used in introducing it into the hole. If cement or other plugs were used, state the character of same and depth placed, from _____ feet to _____ feet for each plug set.

Set 10 foot rock bridge at 3380 feet, dumped 5 sacks cement

Set 10 foot rock bridge at 140 feet, dumped 25 sacks cement.

Mud hole to 30 feet, set 5 foot rock bridge

Dumped 8 sacks cement.

RECEIVED
STATE CORPORATION COMMISSION

DEC 14 1962
12-14-62
CONSERVATION DIV.
Wichita, Kansas

(If additional description is necessary, use BACK of this sheet)

Name of Plugging Contractor Kent Well Servicing Co., Inc.
Address Box 470, El Dorado, Kansas

STATE OF Kansas, COUNTY OF Butler, ss.


(employee of owner) or (owner or operator) of the above-described well, being first duly sworn on oath, says: That I have knowledge of the facts, statements, and matters herein contained and the log of the above-described well as filed and that the same are true and correct. So help me God.

(Signature) Mary Payne

(Address)

SUBSCRIBED AND SWORN to before me this 12th day of December, 1962

My commission expires June 10, 1962

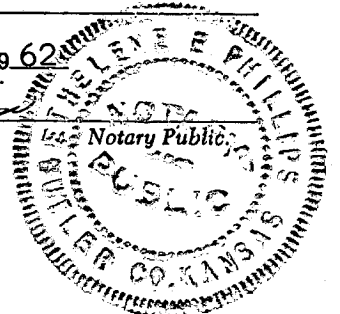

WELL LOG

R

COMPANY **Murfin Drilling Company**

SEC. **11** T. **268** R. **2E**

FARM **Weiskirch**

NO. **5**

LOC. **SW SE SE**

TOTAL DEPTH **4011**

COMM. **6-25-55**


COMP. **7-12-55**

COUNTY **Sedgwick**
KANSAS

SHOT OR TREATED

CONTRACTOR **Murfin Drilling Company**

ISSUED

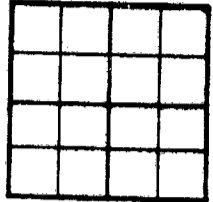

CASING

20	10
15	8 5/8" @ 82' w/40 sx.
12	6
13	4-1/2" @ 3375' w/200 sx.

ELEVATION **1355** KB

PRODUCTION **SWD**

FIGURES INDICATE BOTTOM OF FORMATIONS

130	Lime
400	Lime, shale
595	Lime
615	Lime, shale
1542	Shale, shells
1720	Shale, lime shells
1950	Shale, shells
2200	Shale, lime
2315	Lime, shale
2435	Shale, lime
2630	Lime, shale
2728	Shale, lime
2877	Lime, shale
2879	Lime
2975	Chat
3072	Lime
3103	Lime, shale
3163	Shale, lime
3267	Lime, shale
3315	Sand, shale, lime
4001	Lime
4011	T. D.

Tops:

Kansas City	2384
Miss. Lime	2834
Miss. Chat	2872
Viola	3158
Simpson	3213
Arbuckle	3309
Granite	4010
RTD	4011

DST #1 2871-79
Open 40 min., shut in 20 min., rec. 8' mud, BHP 630#.

DST #2 3158-63
Open 1 hr., shut in 20 min., rec. 1000' fluid, 35' oil, 965' salt water, IF Off, FF 450#, BHP 1155#.

RECEIVED
STATE CORPORATION COMMISSION

FEB 14 1955

CONSERVATION DIVISION
Wichita, Kansas

State of Kansas
County of Sedgwick } ss:

I, W. R. Murfin of the Murfin Drilling Company

upon oath state that the above and foregoing is a true and correct copy of the log of the Weiskirch #5 well.



Fred Murfin
By Am

September 19 55.

Subscribed and sworn to before me this 27th day of September 19 55.
My Commission Expires June 14, 1964

Mary Louise Blume
NOTARY PUBLIC