

R

DISTRICT CONSERVATION AGENT'S REPORT

TO:

State Corporation Commission
Conservation Division
800 Bitting Building
Wichita, Kansas

FILE NO. 123-3

LOCATION SE SE

SEC. 10 TWP. 26 RGE. 2E

Dry Hole Yes Abandoned Oil Well _____ Abandoned Gas Well _____

I have today completed supervision of plugging of:

Well No. I Lease Morris

Operator Mallard Drilling Co Address 1016 Union Nat Bank Bldg Wichita
Kans

Field Greenwich County Sedgwick


Total Depth 3310 Feet.

(Describe briefly the manner in which the well was plugged)

Dumped 8 sacks cement on bottom 9(128 surface pipe left in)

Set 15 sacks cement on 12' rock bridge at 128'

Mud to surface 5 sacks cement cap rock

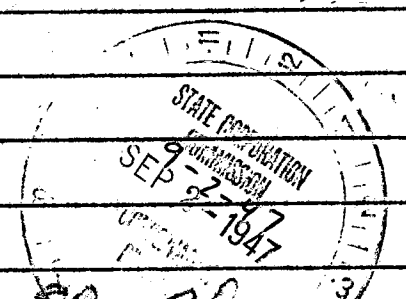

Roy Elliott by

A. G. Garrison
District Conservation Agent

Date Aug 26th 1947