

CARD MUST BE TYPED

State of Kansas

CARD MUST BE SIGNED

NOTICE OF INTENTION TO DRILL

CORRECTION

(see rules on reverse side)

5-28-87

Starting Date February, 25, 1987
month day year

API Number 15-037-21,399-0000

OPERATOR: License # 7169
Name L & M Oil Company
Address Route 1, Box 74
City/State/Zip Mc Cune, KS 66753
Contact Person Doyle Largent
Phone 316-632-4271

* SW SE SE Sec. 33 Twp. 30 S, Rg. 22
280 Ft. from South Line of Section
* 1056 Ft. from East Line of Section

(Note: Locate well on Section Plat on reverse side)

CONTRACTOR: License # 7169
Name L & M Oil Company
City/State Mc Cune, KS 66753

Nearest lease or unit boundary line 280 feet
County Crawford
Lease Name Bennett Well # 59

Well Drilled For: Well Class: Type Equipment:
 Oil SWD Infield Mud Rotary
 Gas Inj Pool Ext. Air Rotary
 OWWO Expl Wildcat Cable

Ground surface elevation 912 feet MSL
Domestic well within 330 feet: yes no
Municipal well within one mile: yes no
Depth to bottom of fresh water.....
Depth to bottom of usable water 100'?

If OWWO: old well info as follows:

Operator
Well Name
Comp Date Old Total Depth.....

Surface pipe by Alternate: 1 2
Surface pipe planned to be set 20'
Conductor pipe required
Projected Total Depth 260 feet
Formation Bartlesville

I certify that well will comply with K.S.A. 55-101, et seq., plus eventually plugging hole to KCC specifications.

Date Feb. 19, 1987 Signature of Operator or Agent Doyle Largent Title Owner

For KCC Use:

Conductor Pipe Required feet; Minimum Surface Pipe Required 20 feet per Alt.

This Authorization Expires 8-20-87 Approved By 2-20-87


kwai: SESESE 1471FEL

Must be filed with the K.C.C. five (5) days prior to commencing well
 This card void if drilling not started within six (6) months of date received by K.C.C.

Important procedures to follow:

1. Notify District office before setting surface casing.
2. Set surface casing by circulating cement to the top.
3. File completion forms ACO-1 with K.C.C. within 90 days of well completion, following instructions on ACO-1, side 1, and including copies of wireline logs.
4. Notify District office 48 hours prior to old well workover or re-entry.
5. Prior to filing Intent, prepare a proposed plugging plan in case well is D & A, then obtain approval of plan when calling district office prior to setting surface pipe.
6. Submit plugging report (CP-4) to K.C.C. after plugging is completed.
7. Obtain an approved injection docket number before disposing of salt water.
8. Notify K.C.C. within 10 days when injection commences or terminates.

**A Regular Section of Land
 1 Mile = 5,280 Ft.**

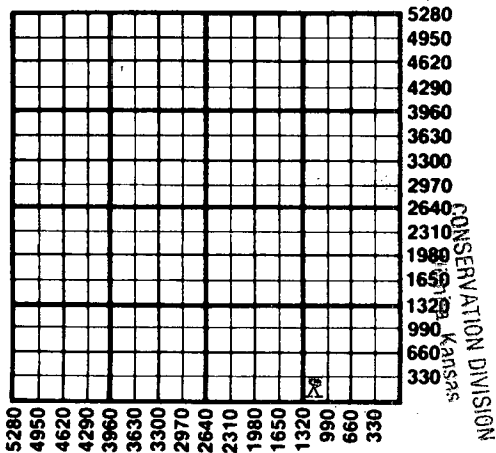

MAY 28 1987
 RECEIVED
 STATE CORPORATION COMMISSION

5-28-87

If an alternate 2 completion, cement in the production pipe from below any usable water to surface within 120 days of spud date.

State Corporation Commission of Kansas
 Conservation Division
 200 Colorado Derby Building
 Wichita, Kansas 67202
 (316) 263-3238