

CARD MUST BE TYPED

State of Kansas

CARD MUST BE SIGNED

NOTICE OF INTENTION TO DRILL

*Correction

(see rules on reverse side)

Starting Date 8/18/86 month day year

API Number 15-037-21,382-0000

OPERATOR: License # 8462

SW/2SW SW 165 4690

Sec. 34 Twp. 30. S, Rg. 22. East

Name Loren Smith

Address Rt. 1

City/State/Zip Oswego, KS 67356

Contact Person Loren Smith

Phone (316) 827-6264

165 Ft. from South Line of Section 4690 Ft. from East Line of Section

(Note: Locate well on Section Plat on reverse side)

CONTRACTOR: License # 8462

Name Loren Smith

City/State Oswego, KS 67356

Nearest lease or unit boundary line 180 feet

County Crawford

Lease Name M. Clawson Well # 4

Ground surface elevation 481 feet MSL

Domestic well within 330 feet: yes no

Municipal well within one mile: yes no

Depth to bottom of fresh water 100

Depth to bottom of usable water 100

Surface pipe by Alternate: 1 2

Surface pipe planned to be set 23

Conductor pipe required

Projected Total Depth 180 feet

Formation Bartlesville

Well Drilled For: Well Class: Type Equipment:

- * Oil SWD * Infield Mud Rotary
Gas Inj Pool Ext Air Rotary
OWWO Expl Wildcat * Cable

If OWWO: old well info as follows:

Operator Well Name Comp Date Old Total Depth

I certify that well will comply with K.S.A. 55-101, et seq., plus eventually plugging hole to KCC specifications.

Date 2/14/86 Signature of Operator or Agent Loren Smith Title Owner

For KCC Use:

Conductor Pipe Required feet; Minimum Surface Pipe Required 20 feet per Alt.

This Authorization Expires 2-18-87 Approved By 8-18-86


X Was nesw nw 3840' f.s.l. & 4140' f.e.l. * I 165' f.s.l. 4690 f.e.l.

Must be filed with the K.C.C. five (5) days prior to commencing well
This card void ~~if not~~ started within six (6) months of date received by K.C.C.

Important procedures to follow:

1. Notify District office before setting surface casing.
2. Set surface casing by circulating cement to the top.
3. File completion forms ACO-1 with K.C.C. within 90 days of well completion, following instructions on ACO-1, side 1, and including copies of wireline logs.
4. Notify District office 48 hours prior to old well workover or re-entry.
5. Prior to filing Intent, prepare a proposed plugging plan in case well is D & A, then obtain approval of plan when calling district office prior to setting surface pipe.
6. Submit plugging report (CP-4) to K.C.C. after plugging is completed.
7. Obtain an approved injection docket number before disposing of salt water.
8. Notify K.C.C. within 10 days when injection commences or terminates.
9. If an alternate 2 completion, cement in the production pipe from below any usable water to surface within 120 days of spud date.

A Regular Section of Land 1 Mile = 5,280 Ft.

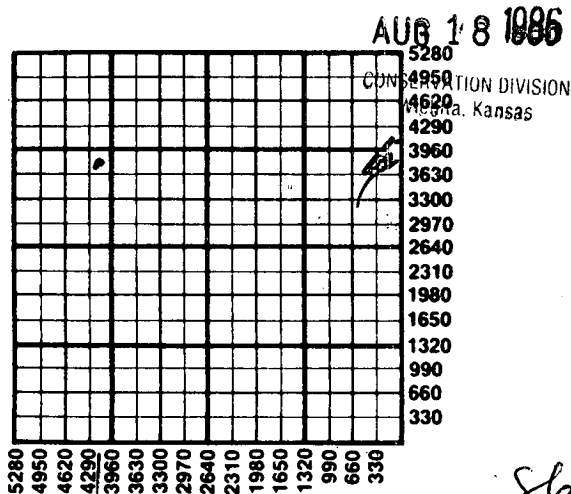

State Corporation Commission of Kansas
Conservation Division
200 Colorado Derby Building
Wichita, Kansas 67202
(316) 263-3238