

NOTICE OF INTENTION TO DRILL

(see rules on reverse side)

8 Starting Date 3/28/87 month day year

API Number 15-037-21,400-00-00

OPERATOR: License # 8462 Name Loren Smith Address Rt. 1 City/State/Zip Oswego, KS 67356 Contact Person Loren Smith Phone 316-827-6264

se sw sw Sec 34 Twp. 30 S, Rg. 22 East West Ft. from South Line of Section Ft. from East Line of Section

CONTRACTOR: License # 8462 Name Loren Smith City/State Oswego, KS 67356

(Note: Locate well on Section Plat on reverse side) Nearest lease or unit boundary line 180 feet County Crawford

Well Drilled For: Well Class: Type Equipment: Oil SWD Infield Mud Rotary Gas Inj Pool Ext Air Rotary OWWO Expl Wildcat Cable

9-21-93

Lease Name M. Clawson Well # 8 Ground surface elevation 481 feet MSL Domestic well within 330 feet: yes no

If OWWO: old well info as follows: Operator Well Name Comp Date Old Total Depth

Municipal well within one mile: yes no Depth to bottom of fresh water 100 Depth to bottom of usable water 100 Surface pipe by Alternate: 1 2 \* Surface pipe planned to be set 23 Conductor pipe required Projected Total Depth 180 Formation Bartlesville

I certify that well will comply with K.S.A. 55-101, et seq., plus eventually plugging hole to KCC specifications. Date 3-23-87 Signature of Operator or Agent Loren Smith Title owner

For KCC Use: Conductor Pipe Required feet; Minimum Surface Pipe Required 20 feet per Alt. This Authorization Expires 9-24-87 Approved By 3-24-87

X Was ne sw nw 3680 f.s. / 4190 f.e. /


X Is se sw sw 280 f.s. / 4565 f.e. /

Must be filed with the K.C.C. five (5) days prior to commencing well  
This card void if drilling not started within six (6) months of date received by K.C.C.

**Important procedures to follow:**

1. Notify District office before setting surface casing.
2. Set surface casing by circulating cement to the top.
3. File completion forms ACO-1 with K.C.C. within 90 days of well completion, following instructions on ACO-1, side 1, and including copies of wireline logs.
4. Notify District office 48 hours prior to old well workover or re-entry.
5. Prior to filing Intent, prepare a proposed plugging plan in case well is D & A, then obtain approval of plan when calling district office prior to setting surface pipe.
6. Submit plugging report (CP-4) to K.C.C. after plugging is completed.
7. Obtain an approved injection docket number before disposing of salt water.
8. Notify K.C.C. within 10 days when injection commences or terminates.
9. If an alternate 2 completion, cement in the production pipe from below any usable water to surface within 120 days of spud date.

**A Regular Section of Land  
1 Mile = 5,280 Ft.**

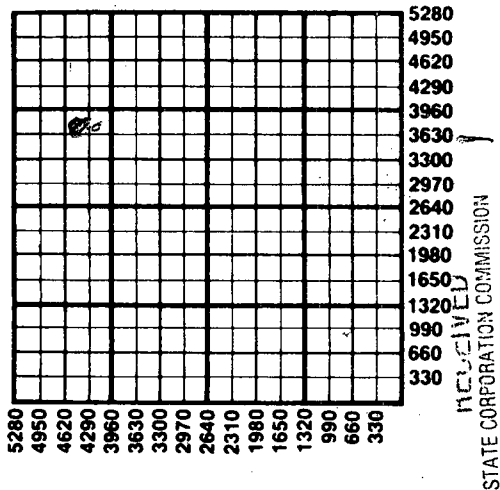

MAR 24 1987

CONSERVATION DIVISION  
Wichita, Kansas

3-24-87

State Corporation Commission of Kansas  
Conservation Division  
200 Colorado Derby Building  
Wichita, Kansas 67202  
(316) 263-3238