

CARD MUST BE TYPED

State of Kansas  
**NOTICE OF INTENTION TO DRILL**  
(see rules on reverse side)

CARD MUST BE SIGNED

Starting Date: 8-21-84  
month day year

API Number 15- 099-22,114-00-00  
 East

OPERATOR: License # 9015  
Name INCO Energy Inc.  
Address P. O. Box 379  
City/State/Zip Parsons, Kansas 67357  
Contact Person E. H. Hare, Jr.  
Phone 316-421-0910

SW SW NE NE Sec 16 Twp 31 S, Rge 21  
(location)

3980 Ft North from Southeast Corner of Section  
1180 Ft West from Southeast Corner of Section  
(Note: Locate well on Section Plat on reverse side)

CONTRACTOR: License # 5782  
Name V W B Drilling Co.  
City/State Cherryvale, Kansas

Nearest lease or unit boundary line 1180 feet.  
County Labette  
Lease Name Wamsley Well# 26

Domestic well within 330 feet:  yes  no  
Municipal well within one mile:  yes  no

Well Drilled For: Well Class: Type Equipment:  
 Oil  Swd  Infield  Mud Rotary  
 Gas  Inj  Pool Ext.  Air Rotary  
 OWWO  Expl  Wildcat  Cable

Depth to Bottom of fresh water Surface feet  
Lowest usable water formation Surface feet  
Depth to Bottom of usable water 15.100 feet  
Surface pipe by Alternate: 1  2

If OWWO: old well info as follows:  
Operator  
Well Name  
Comp Date Old Total Depth  
Projected Total Depth 250 feet  
Projected Formation at TD Skinner Sand  
Expected Producing Formations Skinner Sand

Surface pipe to be set 20 feet  
Conductor pipe if any required feet  
Ground surface elevation 841 feet MSL  
This Authorization Expires 2-17-85  
Approved By 8-17-84 R


I certify that we will comply with K.S.A. 55-101, et seq., plus eventually plugging hole to K.C.C. specifications.

Date 8/16/84 Signature of Operator or Agent Title General Manager  
Form C-1 4/84  
MHC/WONE 8/17/84

Must be filed with the K.C.C. five (5) days prior to commencing well  
 This card void if drilling not started within six (6) months of date received by K.C.C.

**Important procedures to follow:**

**A Regular Section of Land  
 1 Mile = 5,280 Ft.**

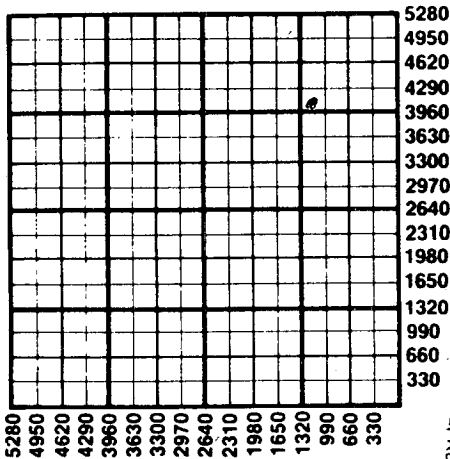

CONSERVATION DIVISION  
 Wichita, Kansas

AUG 17 1984

RECEIVED  
 STATE CORPORATION COMMISSION

1. Notify District office before setting surface casing.
  2. Set surface casing by circulating cement to the top.
  3. File completion forms ACO-1 with K.C.C. within 90 days of well completion, following instructions on ACO-1, side 1, and including copies of wireline logs.
  4. Notify District office 48 hours prior to old well workover or re-entry.
  5. Prior to plugging, prepare a plugging plan, then obtain agreement from the appropriate district office for an approved plugging plan.
  6. Submit plugging report (CP-4) to K.C.C. after plugging is completed.
  7. Obtain an approved injection docket number before disposing of salt water.
  8. Notify K.C.C. within 10 days when injection commences or terminates.
9. If an alternate 2 completion, cement in the production pipe from below an usable water to surface within 120 days of spud date.

State Corporation Commission of Kansas  
 Conservation Division  
 200 Colorado Derby Building  
 Wichita, Kansas 67202

8-17-84 (316) 263-3238