

CARD MUST BE SIGNED

Starting Date: 8 31 84
month day year

OPERATOR: License # 5499
Name Brecheisen Oil Company
Address Box 40
City/State/Zip Garnett, Kansas 66032
Contact Person A. W. Brecheisen
Phone 913-448-6952

CONTRACTOR: License # 5420X 5379
Name Kephart Drilling Company
City/State Thayer, Kansas 66776

Well Drilled For:	Well Class:	Type Equipment:
<input checked="" type="checkbox"/> Oil <input type="checkbox"/> Swd	<input type="checkbox"/> Infield	<input type="checkbox"/> Mud Rotary
<input checked="" type="checkbox"/> Gas <input type="checkbox"/> Inj	<input type="checkbox"/> Pool Ext.	<input checked="" type="checkbox"/> Air Rotary
<input type="checkbox"/> OWWO <input type="checkbox"/> Expl	<input checked="" type="checkbox"/> Wildcat	<input type="checkbox"/> Cable

If OWWO: old weil info as follows:

Operator
Well Name
Comp Date Old Total Depth
Projected Total Depth 1000 feet
Projected Formation at TD
Expected Producing Formations

I certify that we will comply with K.S.A. 55-101, et seq., plus eventually plugging hole to K.C.C. specifications.

API Number 15- 099- 22, 112- 000

SE $\frac{1}{4}$ of NE $\frac{1}{4}$ Sec 10 Twp 31 S, Rge 19
(Location)

...3630..... Ft North from Southeast Corner of Section
990..... Ft West from Southeast Corner of Section
 (Note: Locate well on Section Plat on reverse side)

Nearest lease or unit boundary line ... 990 feet.
County ... Labette

Lease Name L Weidert Well# 4 P 84

Domestic well within 330 feet : ☐ yes ☒ no

Municipal well within one mile : ☐ yes ☒ no

Depth to Bottom of fresh water 100 feet

Lowest usable water formation

Depth to Bottom of usable water 150 feet

Surface pipe by Alternate : 1 ☐ 2X☒

Surface pipe to be set21..... feet

Conductor pipe if any requirednone..... feet

Ground surface elevation feet MSL


This Authorization Expires 2-13-85 1

Approved By 8-13-84 [Signature]

Date 8-9-84 Signature of Operator or Agent Louis Altes Title Office Manager

Must be filed with the K.C.C. five (5) days prior to commencing well
This card void if drilling not started within six (6) months of date received by K.C.C.

A Regular Section of Land
1 Mile = 5,280 Ft.

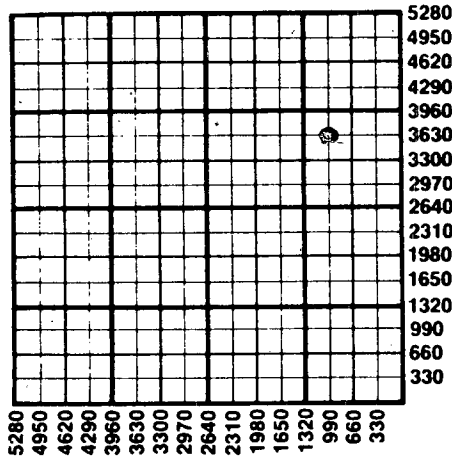

Important procedures to follow :

1. Notify District office before setting surface casing.
2. Set surface casing by circulating cement to the top.
3. File completion forms ACO-1 with K.C.C. within 90 days of well completion, following instructions on ACO-1, side 1, and including copies of wireline logs.
4. Notify District office 48 hours prior to old well workover or re-entry.
5. Prior to plugging, prepare a plugging plan, then obtain agreement from the appropriate district office for an approved plugging plan.
6. Submit plugging report (CP-4) to K.C.C. after plugging is completed.
7. Obtain an approved injection docket number before disposing of salt water.
8. Notify K.C.C. within 10 days when injection commences or terminates.
9. If an alternate 2 completion, cement in the production pipe from below any usable water to surface within 120 days of spud date.

RECEIVED
STATE CORPORATION COMMISSION

AUG 13 1984

CONSERVATION DIVISION
Wichita, Kansas

8-13-84

State Corporation Commission of Kansas
Conservation Division
200 Colorado Derby Building
Wichita, Kansas 67202
(316) 263-3238