

CARD MUST BE TYPED

State of Kansas
NOTICE OF INTENTION TO DRILL
 (see rules on reverse side)

Correction *
 9-25-84

CARD MUST BE SIGNED

Starting Date: 8-27-84
 month day year

OPERATOR: License # 5499
 Name Brecheisen Oil Company
 Address Box 40
 City/State/Zip Garnett, Kansas 66032
 Contact Person A W Brecheisen
 Phone 913-448-6952

CONTRACTOR: License # 5379
 Name Kephart Drilling Company
 City/State Thayer, Kansas 66776

Well Drilled For:	Well Class:	Type Equipment:
<input checked="" type="checkbox"/> Oil	<input type="checkbox"/> Swd	<input type="checkbox"/> Mud Rotary
<input checked="" type="checkbox"/> Gas	<input type="checkbox"/> Inj	<input checked="" type="checkbox"/> Air Rotary
<input type="checkbox"/> OWWO	<input type="checkbox"/> Expl	<input type="checkbox"/> Cable
	<input checked="" type="checkbox"/> Wildcat	

If OWWO: old well info as follows:

Operator

Well Name

Comp Date Old Total Depth

Projected Total Depth 1000 feet

Projected Formation at TD

Expected Producing Formations

I certify that we will comply with K.S.A. 55-101, et seq., plus eventually plugging hole to K.C.C. specifications.

8-9-84

Date 9-21-84 Signature of Operator or Agent

Loris Ulser

Title Office Manager

API Number 15-099-22,108-00-00

~~KOS~~ $\frac{1}{2}$ SE. NW $\frac{1}{4}$ Sec. 11 Twp. 31 S, Rge. 19. ☒ East
 (location) ☐ West

* 3135 Ft North from Southeast Corner of Section

* 3300 Ft West from Southeast Corner of Section
 (Note: Locate well on Section Plat on reverse side)

Nearest lease or unit boundary line 1980 feet.

County Labette

Lease Name Baugher Well # 2 P. 84

Domestic well within 330 feet: ☐ yes ☒ noMunicipal well within one mile: ☐ yes ☒ no

Depth to Bottom of fresh water 100 feet

Lowest usable water formation

Depth to Bottom of usable water 150 feet

Surface pipe by Alternate: 1 ☐ 2 ☒

Surface pipe to be set 21 feet

Conductor pipe if any required none feet

Ground surface elevation feet MSI.

This Authorization Expires 2-13-85

Approved By 8-13-84


SW NW
2970 FSL

4950 FEL

Must be filed with the K.C.C. five (5) days prior to commencing well
This card void if drilling not started within six (6) months of date received by K.C.C.

Important procedures to follow :

A Regular Section of Land
1 Mile = 5,280 Ft.

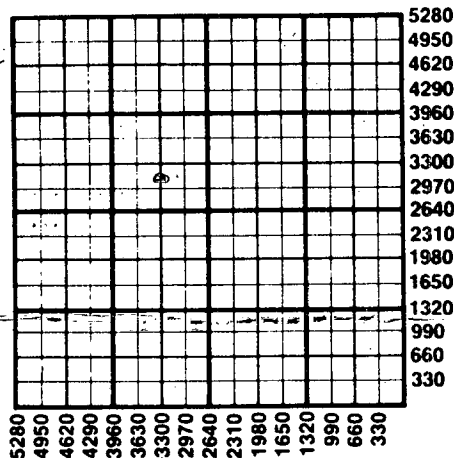

1. Notify District office before setting surface casing.
2. Set surface casing by circulating cement to the top.
3. File completion forms ACO-1 with K.C.C. within 90 days of well completion, following instructions on ACO-1, side 1, and including copies of wireline logs.
4. Notify District office 48 hours prior to old well workover or re-entry.
5. Prior to plugging, prepare a plugging plan, then obtain agreement from the appropriate district office for an approved plugging plan.
6. Submit plugging report (CP-4) to K.C.C. after plugging is completed.
7. Obtain an approved injection docket number before disposing of salt water.
8. Notify K.C.C. within 10 days when injection commences or terminates.
9. If an approved completion, cement in the production pipe from below any usable water to surface within 120 days of spud date.

RECEIVED
STATE CORPORATION COMMISSION

SEP 24 1981

CONSERVATION DIVISION
Wichita, Kansas

9-24-84

State Corporation Commission of Kansas
Conservation Division
200 Colorado Derby Building
Wichita, Kansas 67202
(316) 263-3238