

CARD MUST BE TYPED

State of Kansas
NOTICE OF INTENTION TO DRILL

CARD MUST BE SIGNED

(see rules on reverse side)

Starting Date: 9 28 84
month day year

API Number 15- 099-22,144-0000

OPERATOR: License # 5499

C. N $\frac{1}{2}$ of SW $\frac{1}{4}$ Sec 11. Twp 31. S, Rge 19. East West
(location)

Name Brecheisen Oil Company

Address Box 40

City/State/Zip Garnett, Kansas 66032

Contact Person A W Brecheisen

Phone 913-448-6952

2310 Ft North from Southeast Corner of Section

3960 Ft West from Southeast Corner of Section

(Note: Locate well on Section Plat on reverse side)

CONTRACTOR: License # 5379

Nearest lease or unit boundary line 1320 feet.

County Labette

Name Kephart Drilling Company

Lease Name Baugher Well# 5 P 84

City/State Thayer, Kansas 66776

Domestic well within 330 feet: yes no

Municipal well within one mile: yes no

Well Drilled For: Well Class: Type Equipment:

Oil Swd Infield Mud Rotary

Gas Inj Pool Ext. Air Rotary

OWWO Expl Wildcat Cable

Depth to Bottom of fresh water 100 feet

Lowest usable water formation

Depth to Bottom of usable water 150 feet

Surface pipe by Alternate: 1 2

Surface pipe to be set 21 feet

Conductor pipe if any required none feet

Ground surface elevation feet MSL

This Authorization Expires 3-24-85

Approved By 9-24-84 R

If OWWO: old well info as follows:

Operator

Well Name

Comp Date Old Total Depth

Projected Total Depth 1000 feet

Projected Formation at TD

Expected Producing Formations

I certify that we will comply with K.S.A. 55-101, et seq., plus eventually plugging hole to K.C.C. specifications.

Date 9-21-84 Signature of Operator or Agent

Doris Ulses


Title Office Manager

MHC/WONE 9/24/84

Must be filed with the K.C.C. five (5) days prior to commencing well
This card void if drilling not started within six (6) months of date received by K.C.C.

Important procedures to follow :

**A Regular Section of Land
1 Mile = 5,280 Ft.**

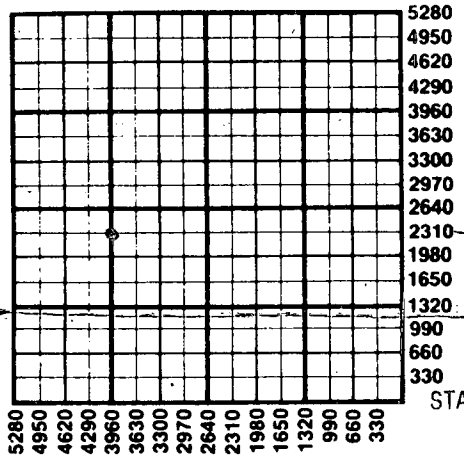

1. Notify District office before setting surface casing.
2. Set surface casing by circulating cement to the top.
3. File completion forms ACO-1 with K.C.C. within 90 days of well completion, following instructions on ACO-1, side 1, and including copies of wireline logs.
4. Notify District office 48 hours prior to old well workover or re-entry.
5. Prior to plugging, prepare a plugging plan, then obtain agreement from the appropriate district office for an approved plugging plan.
6. Submit plugging report (CP-4) to K.C.C. after plugging is completed.
7. Obtain an approved injection docket number before disposing of salt water.
8. Notify K.C.C. within 10 days when injection commences or terminates.

RECEIVED

STATE CORPORATION COMMISSION

9. If an alternate 2 completion, cement in the production pipe from below any usable water to surface within 120 days of spud date.

**State Corporation Commission of Kansas
Conservation Division
200 Colorado Derby Building
Wichita, Kansas 67202
(316) 263-3238**

SEP 24 1984

CONSERVATION DIVISION
Wichita, Kansas

924-84