

CARD MUST BE TYPED

State of Kansas

CARD MUST BE SIGNED

## NOTICE OF INTENTION TO DRILL

(see rules on reverse side)

Starting Date ..... March 27 1986  
month day year 3:45

API Number 15—

099-22,453-00-00

OPERATOR: License # ..... 9313

Name ..... Jim Lorenz

Address ..... R. R. 2

City/State/Zip ..... Parsons, Kansas 67357

Contact Person ..... Rayma

Phone ..... 316 331 8191

CONTRACTOR: License # ..... 5675

Name ..... McPherson Drilling Co.

City/State ..... Route 2, Box 221, Cherryvale, KS 67335

Well Drilled For: Well Class: Type Equipment:

X \_\_\_ Oil \_\_\_ SWD X \_\_\_ Infield \_\_\_ Mud Rotary

X \_\_\_ Gas \_\_\_ Inj \_\_\_ Pool Ext. X \_\_\_ Air Rotary

\_\_\_ OWWO \_\_\_ Expl \_\_\_ Wildcat \_\_\_ Cable

If OWWO: old well info as follows:

Operator .....

Well Name .....

Comp Date ..... Old Total Depth.....

I certify that well will comply with K.S.A. 55-101, et seq., plus eventually plugging hole to KCC specifications.

Date ... 3/25/86 ..... Signature of Operator or Agent Elaine Durham Title .... as. agent .....

For KCC Use:

Conductor Pipe Required ..... feet; Minimum Surface Pipe Required ..... feet per Alt. 1 20

This Authorization Expires ..... 9-25-86 ..... Approved By ..... 3-25-86 ..... Ret/KCC

SW SW NE ..... Sec. 1 Twp. 33 S, Rg. 17 ..... X East

2970 ..... Ft. from South Line of Section

2310 ..... Ft. from East Line of Section

(Note: Locate well on Section Plat on reverse side)

Nearest lease or unit boundary line ..... 330 ..... feet

County ..... Labette

Lease Name ..... R. McNickel ..... Well # ..... 1

Ground surface elevation ..... feet MSL

Domestic well within 330 feet: \_\_\_ yes X \_\_\_ no

Municipal well within one mile: \_\_\_ yes X \_\_\_ no

Depth to bottom of fresh water ..... 20 ..... feet

Depth to bottom of usable water ..... 150 ..... feet

Surface pipe by Alternate: 1 \_\_\_ 2 X

Surface pipe planned to be set ..... 20 ..... feet

Conductor pipe required .....

Projected Total Depth ..... 800 ..... feet


Formation ..... Bartlesville .....

Must be filed with the K.C.C. five (5) days prior to commencing well  
This card void if drilling not started within six (6) months of date received by K.C.C.

**Important procedures to follow:**

1. Notify District office before setting surface casing.
2. Set surface casing by circulating cement to the top.
3. File completion forms ACO-1 with K.C.C. within 90 days of well completion, following instructions on ACO-1, side 1, and including copies of wireline logs.
4. Notify District office 48 hours prior to old well workover or re-entry.
5. Prior to filing Intent, prepare a proposed plugging plan in case well is D & A, then obtain approval of plan when calling district office prior to setting surface pipe.
6. Submit plugging report (CP-4) to K.C.C. after plugging is completed.
7. Obtain an approved injection docket number before disposing of salt water.
8. Notify K.C.C. within 10 days when injection commences or terminates.

**A Regular Section of Land**  
**1 Mile = 5,280 Ft.**

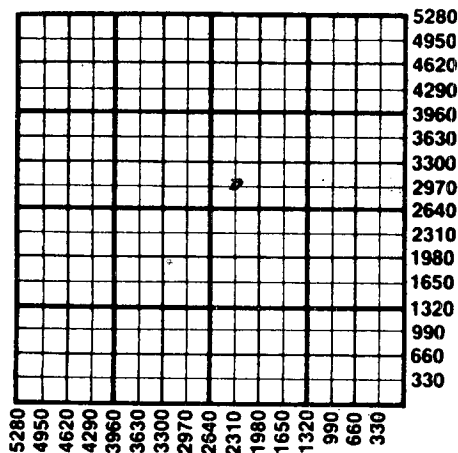

**RECEIVED** If an alternate 2 completion, cement in the production pipe from  
STATE CORPORATION COMMISSION only usable water to surface within 120 days of spud date.

3-25-86

MAR 25 1986

CONSERVATION DIVISION  
Wichita, Kansas

State Corporation Commission of Kansas  
Conservation Division  
200 Colorado Derby Building  
Wichita, Kansas 67202  
(316) 263-3238