

CARD MUST BE TYPED

State of Kansas

CARD MUST BE SIGNED

NOTICE OF INTENTION TO DRILL

(see rules on reverse side)

Starting Date March 31 86
 month day year

OPERATOR: License # 9313
 Name Jim Lorenz
 Address R.R. 2
 City/State/Zip Parson, Kansas 67357
 Contact Person Jim Lorenz
 Phone 316-331-8191

CONTRACTOR: License # 5675
 Name McPherson Drilling Co.
 City/State R 2, Box 221, Cherryvale, KS 67335

Well Drilled For: Well Class: Type Equipment:
☒ Oil ☐ SWD ☒ Infield ☐ Mud Rotary
☒ Gas ☐ Inj ☐ Pool Ext. ☒ Air Rotary
☐ OWWO ☐ Expl ☐ Wildcat ☐ Cable

If OWWO: old well info as follows:

Operator
 Well Name
 Comp Date Old Total Depth

I certify that well will comply with K.S.A. 55-101, et seq., plus eventually plugging hole to KCC specifications.

Date 3/31/86 Signature of Operator or Agent Title as agent

For KCC Use:

Conductor Pipe Required feet; Minimum Surface Pipe Required 20 feet per Alt. 42
 This Authorization Expires 3-31-86 Approved By RCH/KCH

API Number 15- 099-22,458-00-00
 App. 9252
 NE Sec. 1 Twp. 33 S, Rg. 17
 2970 Ft. from South Line of Section
 1320 Ft. from East Line of Section

(Note: Locate well on Section Plat on reverse side)

Nearest lease or unit boundary line 3301 feet
 County Labette
 Lease Name R. McNickel Well # 2
 Ground surface elevation feet MSL
 Domestic well within 330 feet: ☐ yes ☒ no
 Municipal well within one mile: ☐ yes ☒ no
 Depth to bottom of fresh water 20
 Depth to bottom of usable water 150
 Surface pipe by Alternate: 1 ☐ 2 ☒
 Surface pipe planned to be set 20
 Conductor pipe required
 Projected Total Depth 800 feet
 Formation Bartlesville

Must be filed with the K.C.C. five (5) days prior to commencing well
This card void if drilling not started within six (6) months of date received by K.C.C.

Important procedures to follow:


1. Notify District office before setting surface casing.
2. Set surface casing by circulating cement to the top.
3. File completion forms ACO-1 with K.C.C. within 90 days of well completion, following instructions on ACO-1, side 1, and including copies of wireline logs.
4. Notify District office 48 hours prior to old well workover or re-entry.
5. Prior to filing Intent, prepare a proposed plugging plan in case well is D & A, then obtain approval of plan when calling district office prior to setting surface pipe.
6. Submit plugging report (CP-4) to K.C.C. after plugging is completed.
7. Obtain an approved injection docket number before disposing of salt water.
8. Notify K.C.C. within 10 days when injection commences or terminates.
9. If an alternate 2 completion, cement in the production pipe from below any usable water to surface within 120 days of spud date.

RECEIVED
STATE CORPORATION COMMISSION

A Regular Section of Land MAR 31 1986

1 Mile = 5,280 Ft.

CONSERVATION DIVISION
Wichita, Kansas

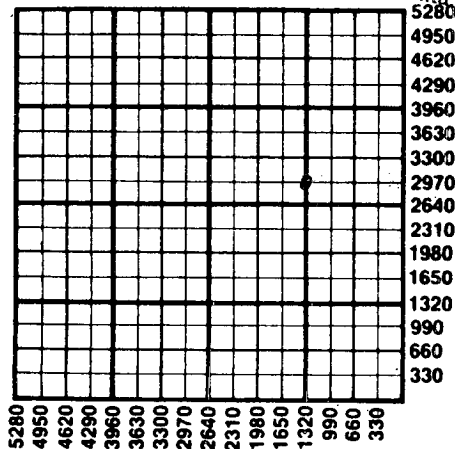

3-31-86

State Corporation Commission of Kansas
Conservation Division
200 Colorado Derby Building
Wichita, Kansas 67202
(316) 263-3238