


15-179-20096-00-00

WELL PLUGGING RECORD

Give All Information Completely
Make Required Affidavit
Mail or Deliver Report to:
Conservation Division
State Corporation Commission
212 No. Market
Wichita, Kansas

NORTH

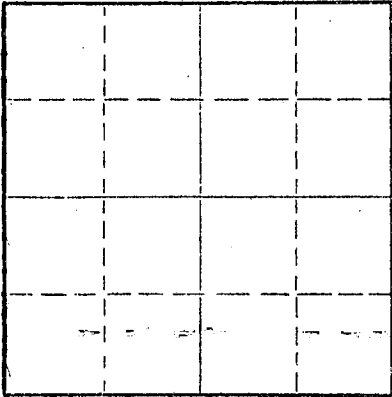

Locate well correctly on above Section Plat

Sheridan County, Sec. 26 Twp. 8 Rge. 29 (E) (W)
SW SW SE

Location as "NE/CNW/SW" or footage from lines _____
Lease Owner Misco Supply Company
Lease Name Edwards #1 Well No. _____
Office Address Wichita, Kansas 67202
Character of Well (completed as Oil, Gas or Dry Hole) _____
Date well completed _____ 19____
Application for plugging filed _____ 19____
Application for plugging approved _____ 19____
Plugging commenced 10/4/68 _____ 19____
Plugging completed 10/7/68 _____ 19____
Reason for abandonment of well or producing formation depleted.

If a producing well is abandoned, date of last production _____ 19____
Was permission obtained from the Conservation Division or its agents before plugging was commenced? yes

Name of Conservation Agent who supervised plugging of this well Nichols
Producing formation _____ Depth to top _____ Bottom _____ Total Depth of Well 4360 Feet
Show depth and thickness of all water, oil and gas formations.

OIL, GAS OR WATER RECORDS

CASING RECORD

FORMATION	CONTENT	FROM	TO	SIZE	PUT IN	PULLED OUT
				8-5/8	250'	none
				4 1/2"	4360'	1295'

Describe in detail the manner in which the well was plugged, indicating where the mud fluid was placed and the method or methods used in introducing it into the hole. If cement or other plugs were used, state the character of same and depth placed, from _____ feet to _____ feet for each plug set.

Checked hole to 4100' and ran sand to 4150', set 3 sacks of cement.
Shot pipe at 3741', 3592', 2478', 1809', 1620', 1497', 1395' and 1305'.
Got loose and pulled 42 joints. Pumped 130 sacks posmix and 30 sacks gel, 5 sacks hulls. Tailed pipe.

PLUGGING COMPLETE.

RECEIVED
STATE CORPORATION COMMISSION
OCT 28 1968
CONSERVATION DIVISION
Wichita, Kansas

10-8-68


Name of Plugging Contractor CHASE, KANSAS
Address _____

STATE OF KANSAS RICE
NOEL J. COONEY, ss.

(employee of owner) or (owner or operator) of the above-described well, being first duly sworn on oath, says: That I have knowledge of the facts, statements, and matters herein contained and the log of the above-described well as filed and that the same are true and correct. So help me God.

(Signature) Paul Knight
CHASE, KANSAS

Subscribed and Sworn before me this 8th day of October, 1968

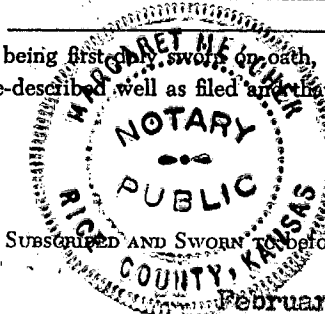

February 15, 1971

Margaret Melcher
Notary Public.

15-179-20096-00-00

DRILLER'S LOG

COMPANY: Larry Burkholz
 CONTRACTOR: LEBEN DRILLING, INC.
 FARM: EDWARDS #1
 LOCATION: SW SW SE SECTION 26-8S-29W
 SHERIDAN COUNTY, KANSAS
 COMMENCED: 5-1-68
 COMPLETED: 5-9-68

0	60	Surface clay
60	190	Sand, gravel
190	1680	Shale
1680	2020	Shale, lime
2020	2427	Shale
2427	2464	Anhydrite
2464	2950	Shale, Lime
2950	3280	Lime, shale
3280	3350	Lime
3350	3455	Lime, shale
3455	4180	Lime
	<u>4180</u>	<u>RTD - Set 4 1/2" Casing</u>

8 5/8" 8 rd. 20# surface casing set @ 250' cemented with 200 sacks Common, 2% cc

I, Leslie Kite, do hereby certify that the above and foregoing is a true and correct copy of the log of the Edwards #1 Well, located SW SW SE of Section 26, Township 8 South, Range 29 West, Sheridan County, Kansas, as reflected by the records of Leben Drilling, Inc.

Leslie Kite
 Leslie Kite

STATE OF KANSAS)
) SS
 COUNTY OF BARTON)

Subscribed and sworn to and before me, a Notary Public, in and for Barton County, Kansas, this 10th day of May, 1968.

Ulanda Nichols
 Ulanda Nichols

My Commission Expires:
 April 1, 1971

RECEIVED
 STATE CORPORATION COMMISSION
 OCT 7 - 1968
 CONSERVATION DIVISION
 Wichita, Kansas
 10-7-68