

15-179-20291-00-00


STATE OF KANSAS
STATE CORPORATION COMMISSION

Form CP-4

Give All Information Completely
Make Required Affidavit
Mail or Deliver Report to:
Conservation Division
State Corporation Commission
211 No. Broadway
Wichita, Kansas

WELL PLUGGING RECORD

NORTH

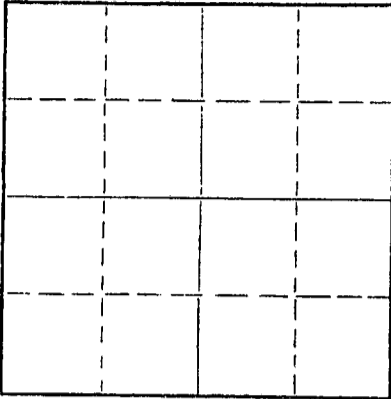

Locate well correctly on above
Section Plat

Sheridan County. Sec. 26 Twp. 8 Rge. 29W (E) (W)

Location as "NE/CNW/SW" or footage from lines. NW SE

Lease Owner Halliburton Oil Producing Company

Lease Name Edwards Well No. 1

Office Address 117 Cameron Bldg., Oklahoma City, Okla. 73106

Character of Well (completed as Oil, Gas or Dry Hole) Dry hole

Date well completed October 28, 1971 19

Application for plugging filed October 26, 1971 19

Application for plugging approved October 27, 1971 19

Plugging commenced October 28, 1971 19

Plugging completed October 28, 1971 19

Reason for abandonment of well or producing formation Dry hole

If a producing well is abandoned, date of last production _____ 19

Was permission obtained from the Conservation Division or its agents before plugging was commenced? Yes

Name of Conservation Agent who supervised plugging of this well Bill Nichols, Moreland, Kansas

Producing formation _____ Depth to top _____ Bottom _____ Total Depth of Well 4110 Feet

Show depth and thickness of all water, oil and gas formations.

OIL, GAS OR WATER RECORDS

CASING RECORD

FORMATION	CONTENT	FROM	TO	SIZE	PUT IN	PULLED OUT
		0	206'	8 5/8"		

Describe in detail the manner in which the well was plugged, indicating where the mud fluid was placed and the method or methods used in introducing it into the hole. If cement or other plugs were used, state the character of same and depth placed, from _____ feet to _____ feet for each plug set.

Plugged through drill pipe @ 1425' w/100 sacks cement
Plugged through drill pipe @ 225' w/25 sacks cement
Plugged through drill pipe @ 40' w/10 sacks cement

RECEIVED
STATE CORPORATION COMMISSION
OCT 29 1971
CONSERVATION DIVISION
Wichita, Kansas

10-29-71

(If additional description is necessary, use BACK of this sheet)

Name of Plugging Contractor Chief Drilling Co., Inc.

Address Suite 905 Century Plaza, Wichita, Kansas 67202

STATE OF KANSAS COUNTY OF SEDGWICK, ss.
Jim Robinson (employee of owner) or (owner or operator) of the above-described

well, being first duly sworn on oath, says: That I have knowledge of the facts, statements, and matters herein contained and the log of the above-described well as filed and that the same are true and correct. So help me God.

(Signature) Jim Robinson

Suite 905 Century Plaza, Wichita, Kans.
(Address)

SUBSCRIBED AND SWORN to before me this 28th day of October, 19 71

My Commission Expires August 5, 1975

Virginia S. Fabian
Virginia S. Fabian Notary Public.



15-179-20291-00-00

WELL LOG

HALLIBURTON OIL PRODUCING CO.
117 Cameron Building
Oklahoma City, Oklahoma 73106

#1 EDWARDS
C NW SE Sec. 26-8-29W
Sheridan County, Kans.

CONTRACTOR: Chief Drilling Co., Inc.
CASING RECORD: Set 197.94 of 8 5/8"
w/275 sacks cement.

COMMENCED: 10/18/71
COMPLETED: 10/28/71

FORMATION	FROM	TO	ELEVATION
			2734 Gr.
			2736 D.F.
			2739 K.B.
Sand & Shale	0	2200	
Shale & Shells	2200	2359	
Anhydrite	2359	2394	
Shale	2394	2770	
Shale & Lime	2770	3370	
Lime & Shale	3370	3410	
Shale & Lime	3410	3522	
Lime & Shale	3522	3542	
Shale & Lime	3542	3738	
Lime & Shale	3738	3802	
Lime	3802	4100	
Total Depth	4100		

ELECTRIC LOG TOPS

Anhydrite	2360
Base Anhy.	2394
Howard	3522
Topeka	3606
Heebner	3817
Toronto	3841
Lansing	3855
Base K. C.	4094
T. D.	4105

RECEIVED
STATE CORPORATION COMMISSION
NOV 2 1971
CONSERVATION DIVISION
Wichita, Kansas

11-2-71

STATE OF KANSAS, COUNTY OF SEDGWICK) ss:

I hereby certify that the above is a true and correct copy of the Driller's Log of the well drilled in the C-NW-SE of Section 26-8-29W, Sheridan County, Kansas, to the best of my knowledge and belief.

CHIEF DRILLING CO., INC.

Jim Robinson
Jim Robinson, Office Manager

Virginia S. Fabian
Virginia S. Fabian, Notary Public

