

15-179-20098-00-00


Give All Information Completely
Make Required Affidavit
Mail or Deliver Report to:
Conservation Division
State Corporation Commission
212 No. Market
Wichita, Kansas

WELL PLUGGING RECORD

Sheridan County, Sec. 29 Twp. 8S Rge. 29 ~~W~~ (W)

Location as "NE/CNW%SW%" or footage from lines App. C SE SE
Lease Owner Ted Gore
Lease Name Koster Well No. 1
Office Address 650 Fourth Nat'l bldg - Wichita, Kansas
Character of Well (completed as Oil, Gas or Dry Hole) Dry Hole
Date well completed 5-25 1968
Application for plugging filed 5-25 1968
Application for plugging approved 5-25 1968
Plugging commenced 5-25 1968
Plugging completed 5-25 1968
Reason for abandonment of well or producing formation Dry Hole

NORTH

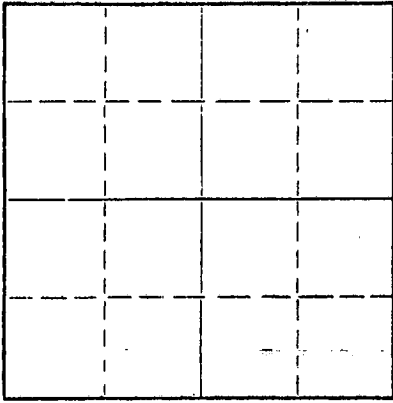

Locate well correctly on above Section Plat

If a producing well is abandoned, date of last production 19
Was permission obtained from the Conservation Division or its agents before plugging was commenced? Yes

Name of Conservation Agent who supervised plugging of this well W. L. Nichols Morland, Kansas
Producing formation Depth to top Bottom Total Depth of Well 4140 Feet
Show depth and thickness of all water, oil and gas formations.

OIL, GAS OR WATER RECORDS

CASING RECORD

FORMATION	CONTENT	FROM	TO	SIZE	PUT IN	PULLED OUT
				8 5/8"	222.09'	None

Describe in detail the manner in which the well was plugged, indicating where the mud fluid was placed and the method or methods used in introducing it into the hole. If cement or other plugs were used, state the character of same and depth placed, from feet to feet for each plug set.

Set plug @ 1450' w/100 sx Poz 6% Gel
Set plug @ 245' w/20 sx Poz. 6% Gel
Set plug @ 40' w/1/2 sx Hulls 10 sx Poz 6% Gel

RECEIVED
STATE CORPORATION COMMISSION
MAY 29 1968
CONSERVATION DIVISION
Wichita, Kansas

5-29-68

(If additional description is necessary, use BACK of this sheet)
Name of Plugging Contractor Leben Drilling, Inc.
Address P. O. Box 486 - Great Bend, Kansas 67530

STATE OF Kansas, COUNTY OF Barton, ss.
Leslie Kite (employee of owner) or (owner or operator) of the above-described

well, being first duly sworn on oath, says: That I have knowledge of the facts, statements, and matters herein contained and the log of the above-described well as filed and that the same are true and correct. So help me God.

(Signature) Leslie Kite

P. O. Box 486 - Great Bend, Kansas 67530 (Address)

Subscribed and Sworn to before me this 28th day of May, 1968



Ulanda Nichols Notary Public.

My commission expires April 1, 1971

15-179-20098-0000

COMPANY
CONTRACTOR
FARM
LOCATION

Ted Gore
LEBEN DRILLING, INC.
KOSTER #1
App. C SE SE Sec. 29-8s-29w
SHERIDAN COUNTY, KANSAS
5-18-68
5-25-68

COMMENCED
COMPLETED

0	180	Clay and Sand
180	1200	Shale
1200	2120	Sand and Shale
2120	2340	Shale and Sand
2340	2423	Red Bad
2423	2460	Anhydrite
2460	2600	Shale and Lime
2600	3565	Lime and Shale
3565	4140	Lime
	4140	RTD - D & A

RECEIVED
STATE CORPORATION COMMISSION
MAY 29 1968
CONSERVATION DIVISION
Wichita, Kansas

5-29-68

Set 8 5/8" - Used 28# Surface Casing - @ 230' with 210 sx common cement
2% cc

I, Leslie Kite, do hereby certify that the above and foregoing is a true
and correct copy of the log of the Koster #1, located App. C SE SE of
Section 29, Township 8 South, Range 29 West, Sheridan County, Kansas, as
reflected by the files of Leben Drilling, Inc.

Leslie Kite
Leslie Kite

STATE OF KANSAS)
) SS
COUNTY OF BARTON)

Subscribed and sworn to before me, a Notary Public, in and
for Barton County, Kansas, this 28th day of May, 1968.

Ulanda Nichols
Ulanda Nichols - Notary Public

My Commission Expires - April 1, 1971

