


Give All Information Completely
Make Required Affidavit
Mail or Deliver Report to:
Conservation Division
State Corporation Commission
211 No. Broadway
Wichita, Kansas

WELL PLUGGING RECORD

NORTH

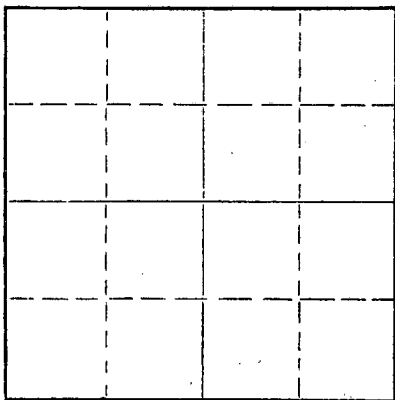

Locate well correctly on above
Section Plat

Sheridan County. Sec. 2 Twp. 8S Rge. (E) 30 (W)
Location as "NE/CNW%SW%" or footage from lines SE SE SE
Lease Owner John O. Farmer, Inc.
Lease Name MOSS Well No. 1
Office Address Russell, Kansas
Character of Well (completed as Oil, Gas or Dry Hole) Dry
Date well completed 5/25 19 58
Application for plugging filed 5/25 19 58
Application for plugging approved 5/25 19 58
Plugging commenced 5/25 19 58
Plugging completed 5/25 19 58
Reason for abandonment of well or producing formation Dry

If a producing well is abandoned, date of last production 19
Was permission obtained from the Conservation Division or its agents before plugging was commenced? yes

Name of Conservation Agent who supervised plugging of this well Mr. Fabricius, Hill City, Kansas
Producing formation Depth to top Bottom Total Depth of Well 4285 Feet
Show depth and thickness of all water, oil and gas formations.

OIL, GAS OR WATER RECORDS

CASING RECORD

FORMATION	CONTENT	FROM	TO	SIZE	PUT IN	PULLED OUT
				8-5/8	325	None

Describe in detail the manner in which the well was plugged, indicating where the mud fluid was placed and the method or methods used in introducing it into the hole. If cement or other plugs were used, state the character of same and depth placed, from feet to feet for each plug set.

First plug set at 600 feet with 20 sacks cement

Second plug set at 320 feet with 20 sacks cement

Last plug set at 40 feet with 10 sacks cement.

RECEIVED
STATE CORPORATION COMMISSION

JUN 2 1958
06-02-1958
CONSERVATION DIVISION
Wichita, Kansas

(If additional description is necessary, use BACK of this sheet)
Name of Plugging Contractor John O. Farmer, Inc.
Address Russell, Kansas


STATE OF Kansas, COUNTY OF Russell, ss.
JOHN O. FARMER (owner or operator) of the above-described well, being first duly sworn on oath, says: That I have knowledge of the facts, statements, and matters herein contained and the log of the above-described well as filed and that the same are true and correct. So help me God.

(Signature) John O. Farmer
Russell, Kansas
(Address)

SUBSCRIBED AND SWORN TO before me this 27th day of May, 19 58
October 11, 1958
My commission expires

Lucille Kennedy
Lucille Kennedy
Notary Public.

PLUGGING
FILE SEC 2 T. 8 R. 30W
BOOK 104 LINE 22

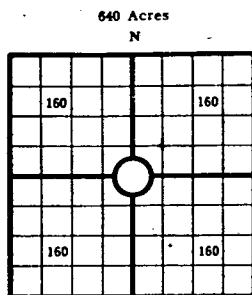OPERATOR John O. Farmer, Inc.ADDRESS Russell, Kansas

Locate well correctly

COUNTY Sheridan SEC. 2 TWP. 8S RGE. 30W
 COMPANY OPERATING John O. Farmer, Inc.
 OFFICE ADDRESS Russell, Kansas
 FARM NAME MOSS WELL NO. 1
 DRILLING STARTED 5/14, 1958 DRILLING FINISHED 5/25, 1958
 DATE OF FIRST PRODUCTION _____ COMPLETED _____
 WELL LOCATED SE 1/4 SE 1/4 SE 1/4 North of South
 Line and _____ ft. East of West Line of Quarter Section
 Elevation (Relative to sea level) DERRICK FLOOR 2933 GROUND 2928
 CHARACTER OF WELL (Oil, gas or dryhole) Dry

OIL OR GAS SANDS OR ZONES

Name	From	To	Name	From	To
1			4		
2			5		
3			6		

Perforating Record If Any

Shot Record

Formation	From	To	No. of Shots	Formation	From	To	Size of Shot

CASING RECORD

Amount Set								Amount Pulled		Packer Record	
Size	Wt.	Thds.	Make	Ft.	In.	Ft.	In.	Size	Length	Depth Set	Make
8-5/8				325							

Liner Record: Amount _____ Kind _____ Top _____ Bottom _____

CEMENTING AND MUDDING

Size	Amount Set		Sacks Cement	Chemical		Method of Cementing	Amount	Mudding Method	Results (See Note)
	Ft.	In.		Gal.	Make				
8-5/8	325		150						

Note: What method was used to protect sands if outer strings were pulled? _____

NOTE: Were bottom hole plugs used? _____ If so, state kind, depth set and results obtained _____

TOOLS USED

Rotary Tools were used from _____ feet to _____ feet. Cable tools were used from _____ feet to _____

feet, and from _____ feet to _____ feet, and from _____ feet to _____

Type Rig _____

INITIAL PRODUCTION TEST

Describe initial test: whether by flow through tubing or casing or by pumping _____

Amount of Oil Production _____ bbls. Size of choke, if any _____ Length of test _____ Water

Production _____ bbls. Gravity of oil _____ Type of Pump if pump is used, describe _____

15-179-00060-00-00 FORMATION RECORD

Give detailed description and thickness of all formations drilled through, contents of sand, whether dry, water, oil or gas.

Formation	Top	Bottom	Formation	Top	Bottom
Shale & sand	0	325			
Shale	325	1470			
Sand & shale	1470	1680			
Shale	1680	1780			
Sand & shale	1780	1900			
Shale & shells	1900	2588			
Anhydrite	2588	2630			
Shale & redbed	2630	2795			
Shale & shells	2795	2880			
Shale & lime	2880	3730			
Lime & shale	3730	4153			
Lime	4153	4235			
Lime & shale	4235	4285			
T.D.		4285			

SAMPLE TOPS:

Elevation:	RB	2933
Howard		3692
Topeka		3804
Heebner		4002
Toronto		4024
Lansing		4039
KKK B/KC		4282
T.D.		4285

D & A

SHALE
 JUN 2 1958
 CONSERVATION DIVISION

I, the undersigned, being first duly sworn upon oath, state that the well record is true, correct and complete according to the records of this office and to the best of my knowledge and belief.

John O. Farmer Resident
 Name and title of representative of company

Subscribed and sworn to before me this 27th day of May, 1958
 My Commission expires 10/11/58
Smiller Ramsey
 Notary Public

WELL NO. 1 COUNTY, Sheridan SEC. 2, TWP. 8S, RGE. 30W
 FARM NAME MOSS

PLUGGING
 FILE SEC 2, T 8 R 30W
 BOOK PAGE 104 LINE 22