


WELL PLUGGING RECORD

Give All Information Completely
Make Required Affidavit
Mail or Deliver Report to:
Conservation Division
State Corporation Commission
800 Bitting Building
Wichita, Kansas

NORTH

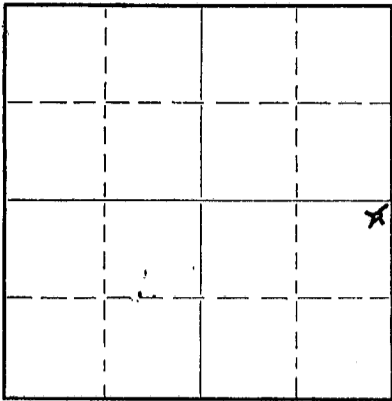

Locate well correctly on above
Section Plat

Sheridan County. Sec. *11* Twp. *8* Rge. *30* (W)
Location as "NE/CNW $\frac{1}{4}$ /SW $\frac{1}{4}$ " or footage from lines *NE NE SE*
Lease Owner *Anderson - Mumford - Moss*
Lease Name *Tilma* Well No. *1*
Office Address *Vick Anderson - Seiden. Kans.*
Character of Well (completed as Oil, Gas or Dry Hole) *dry*
Date well completed *9-14-53* 19
Application for plugging filed 19
Application for plugging approved 19
Plugging commenced *9-14-53* 19
Plugging completed 19
Reason for abandonment of well or producing formation
last hole
If a producing well is abandoned, date of last production 19
Was permission obtained from the Conservation Division or its agents before plugging was commenced?

Name of Conservation Agent who supervised plugging of this well
Producing formation Depth to top Bottom *1008* Total Depth of Well *1008* Feet
Show depth and thickness of all water, oil and gas formations.

OIL, GAS OR WATER RECORDS

CASING RECORD

Formation	Content	From	To	Size	Put In	Pulled Out
				<i>7</i>	<i>192</i>	<i>None</i>

Describe in detail the manner in which the well was plugged, indicating where the mud fluid was placed and the method or methods used in introducing it into the hole. If cement or other plugs were used, state the character of same and depth placed, from feet to feet for each plug set.

800' of rotary pipe - lost in hole -
Set sand bridge at 208 - 550# cement on top sand at 208. Filled hole with mud - changed to 35 - set bridge at 35. Filled with cement to bottom cellar -

(If additional description is necessary, use BACK of this sheet)

Correspondence regarding this well should be addressed to

Address

STATE OF *Ellis* Kansas, COUNTY OF *Ellis*, ss.
Julius Ehrlich (employee of owner) or (owner or operator) of the above-described well,
being first duly sworn on oath, says: That I have knowledge of the facts, statements, and matters herein contained and the log of the above-described well as filed and that the same are true and correct. So help me God.

(Signature) *Julius Ehrlich*

(Address)

SUBSCRIBED AND SWORN TO before me this *8th* day of *December*, 19*53*

My commission expires *June 16, 1955*

A. J. Brubaker
Notary Public.

22-5133-9 9-48-10M
PLUGGING
FILE SEC *11 T 8 R 30W*
BOOK PAGE *148* LINE *28*

12-10-1953

15-179-05145-00-00

MASSEY-HARRIS Sales and Service


ANDERSON IMPLEMENT CO.

Selden, Kansas

12-11-53

Massey Harris - Hardware

TRACTORS • COMBINES • FARM IMPLEMENTS

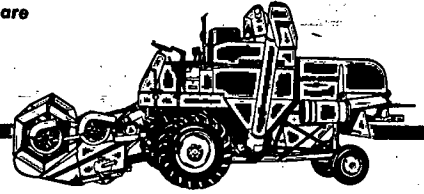

Mr Eldon Petty
Box 324 Hays
Kans

Dear Mr Petty
I am enclosing check for 10.00 as per
letter recd to day from P Roberts with a
to am marking from the samples of
cuttings that I had log & permit get
as I cant find which he seemed to
have shipped out he bought cement
& plugged the hole & left unknown to
me
Yours truly
Victor Anderson

RECEIVED
STATE CONSERVATION DIVISION
DEC 16 1953
CONSERVATION DIVISION
Wichita, Kansas



BETTER ENGINEERED, BETTER BUILT FARM EQUIPMENT SINCE 1847

15-179-05145-00-00

Speck:

Mr. Julius Ehrlich of Claflin, Kans., filled in these papers for me and said to invoice these lease owners for the plugging fee as they are the lease owners, however if they did not pay in a reasonable time to bill him for the plugging and he would remit. It seems that he will have to sue them any-way,

Petty

RECEIVED
STATE COMMISSION

CONSERVATION DIVISION
Wichita, Kansas