

15-179-20533-00-00


STATE OF KANSAS  
STATE CORPORATION COMMISSION

WELL PLUGGING RECORD

Give All Information Completely  
Make Required Affidavit  
Mail or Deliver Report to  
Conservation Division  
State Corporation Comm.  
245 North Water  
Wichita, KS 67202

Sheridan County, Sec. 25 Twp. 8S Rge. 30WE/W  
Location as "NE/CNW $\frac{1}{4}$ SW $\frac{1}{4}$ " or footage from lines  
NW NE

Lease Owner Voyager Petroleums, Inc. - Godsey-Earlouche  
Lease Name Schlageck Well No. 1  
Office Address 6600 So. Yale, Tulsa, Oklahoma 74136  
Character of Well (Completed as Oil, Gas or Dry Hole)  
No commercial quantity of oil or gas encountered  
Date Well completed March 28 1979  
Application for plugging filed (verbally) March 28 1979  
Application for plugging approved (verbally) March 28 1979  
Plugging commenced March 28 1979  
Plugging completed March 28 1979  
Reason for abandonment of well or producing formation  
No commercial quantity of oil or gas encountered.  
If a producing well is abandoned, date of last production 19

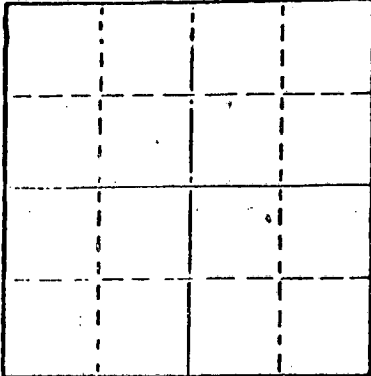

Locate well correctly on above  
Section Plat

Was permission obtained from the Conservation Division or  
its agents before plugging was commenced? Yes

Name of Conservation Agent who supervised plugging of this well Gilbert Balthazor  
Producing formation \_\_\_\_\_ Depth to top \_\_\_\_\_ Bottom \_\_\_\_\_ Total Depth of Well 4638'  
Show depth and thickness of all water, oil and gas formations.

OIL, GAS OR WATER RECORDS

CASING RECORD

FORMATION	CONTENT	FROM	TO	SIZE	PUT IN	PULLED OUT

Describe in detail the manner in which the well was plugged, indicating where the mud fluid  
was placed and the method or methods used in introducing it into the hold. If cement or other  
plugs were used, state the character of same and depth placed, from \_\_\_\_\_ feet to  
\_\_\_\_\_ feet for each plug set.

T.D. 4638'  
Set 1st plug at 1500' with 70 sacks  
2nd plug at 240' with 20 sacks,  
3rd plug at 40' solid bridge with 10 sacks  
rathole with 5 sacks  
Cemented with 50/50 posmix, 6% Gel.  
Plug was down at 10:30 p.m., 3-28-79.

RECEIVED  
STATE CORPORATION COMMISSION  
APR - 6 1979  
04-06-1979  
CONSERVATION DIVISION  
Wichita, Kansas


(If additional description is necessary, use BACK of this sheet)

Name of Plugging Contractor Abercrombie Drilling, Inc.

STATE OF Kansas COUNTY OF Sedgwick, ss.  
Jerry A. Langrehr, Executive Vice-President (employee of owner) or (owner or operator)  
of the above-described well, being first duly sworn on oath, says: That I have knowledge of  
the facts, statements, and matters herein contained and the log of the above-described well  
as filed and that the same are true and correct. So help me God.

(Signature) Jerry A. Langrehr  
801 Union Center, Wichita, Kansas 67202  
(Address)

SUBSCRIBED AND SWORN TO before me this 5th day of April, 19 79

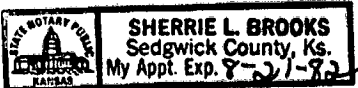

Sherrie L. Brooks  
Sherrie L. Brooks Notary Public.

My commission expires 8-21-82

15-119-20533-00-00  
 CONTRACTOR'S WELL LOG

OPERATOR: Voyager Petroleum, Inc.  
 Godsey-Earlougher Division  
 CONTRACTOR: Abercrombie Drilling, Inc.  
 WELL NAME: Schlageck #1  
 LOCATION: NW NE, Section 25-8S-30W  
 Sheridan County, Kansas  
 SPUD DATE: March 18, 1979  
 COMPLETION DATE: March 28, 1979

0	257	Clay, sand and clay
257	702	Sand and shale
702	2619	Shale and sand
2619	2657	Anhydrite
2657	3188	Shale
3188	3375	Shale and lime
3375	3554	Shale
3554	3720	Shale and lime
3720	4638	Lime
	4638	Rotary Total Depth

Spud hole at 7:00 p.m., March 18, 1979. Drilled 258' of 12 1/4" hole. Ran 6 joints of 8-5/8" - 28# casing. Set at 257' K.B. with 200 sacks of common cement, 3% Ca.Cl. Cement did circulate. Plug was down at 11:45 p.m., March 18, 1979.

T.D. 4638'. Set 1st plug at 1500' with 70 sacks, 2nd plug at 240' with 20 sacks, 3rd plug at 40' solid bridge with 10 sacks, rathole with 5 sacks. Cemented with 50/50 posmix, 6% gel. Plug was down at 10:30 p.m., March 28, 1979.

SAMPLE TOPS:

Anhydrite 2619'  
 B/Anhydrite 2657'

RECEIVED  
 STATE CORPORATION COMMISSION

APR - 6 1979

STATE OF KANSAS )  
 ) ss  
 COUNTY OF SEDGWICK )

CONSERVATION DIVISION  
 Wichita, Kansas

Jerry A. Langrehr, Executive Vice-President of Abercrombie Drilling, Inc., does hereby state that the above and foregoing is a true and correct copy of the log of the Schlageck #1, NW NE, Section 25-8S-30W, Sheridan County, Kansas.

ABERCROMBIE DRILLING, INC.

BY Jerry A. Langrehr  
 Jerry A. Langrehr  
 Executive Vice-President

Subscribed and sworn to before me, a Notary Public, in and for the county and state aforesaid, as of this 5th day of April, 1979.



Sherrie L. Brooks  
 Sherrie Brooks, Notary Public

My commission expires 8-21-82.