


15-179-20566-00-00

Give All Information Completely
Make Required Affidavit
Mail or Deliver Report to:
Conservation Division
State Corporation Commission
P. O. Box 17027
Wichita, Kansas 67217
NORTH

WELL PLUGGING RECORD

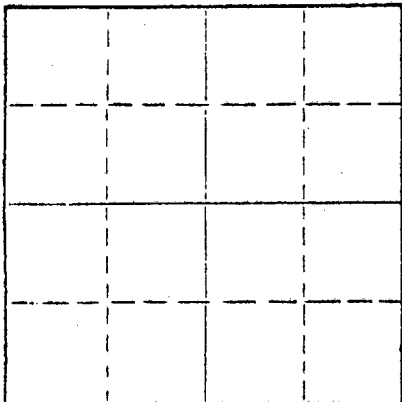

Locate well correctly on above Section Plat

SHERIDAN County. Sec. 25 Twp. 8S Rge. (E) 30W (W)
Location as "NE/CNW/SW" or footage from lines 100' W of SW NE
Lease Owner DONALD C. SLAWSON & MURFIN DRILLING CO., INC.
Lease Name SCHLAGECK 'A' Well No. 1
Office Address 200 Douglas Building Wichita, Kansas 67202
Character of Well (completed as Oil, Gas or Dry Hole) Dry Hole
Date well completed August 18, 1980
Application for plugging filed August 17, 1980
Application for plugging approved August 17, 1980
Plugging commenced August 17, 1980
Plugging completed August 18, 1980
Reason for abandonment of well or producing formation Dry Hole

If a producing well is abandoned, date of last production 19
Was permission obtained from the Conservation Division or its agents before plugging was commenced? Yes

Name of Conservation Agent who supervised plugging of this well Gilbert Balthazor
Producing formation _____ Depth to top _____ Bottom _____ Total Depth of Well 4571 Feet
Show depth and thickness of all water, oil and gas formations.

OIL, GAS OR WATER RECORDS

CASING RECORD

FORMATION	CONTENT	FROM	TO	SIZE	PUT IN	PULLED OUT
	379.76'	surface	387'	8 5/8"		

Describe in detail the manner in which the well was plugged, indicating where the mud fluid was placed and the method or methods used in introducing it into the hole. If cement or other plugs were used, state the character of same and depth placed, from _____ feet to _____ feet for each plug set.

1st plug @ 1400' w/70 sx
2nd plug @ 360' w/20 sx
Solid Bridge @ 40' w/10 sx
5 sx in Rat Hole

RECEIVED
STATE CORPORATION COMMISSION
SEP 24 1980
CONSERVATION DIVISION
Wichita, Kansas

Name of Plugging Contractor SUN OIL WELL CEMENTING, INC.
Address Box 169 Great Bend, Kansas 67530

STATE OF KANSAS, COUNTY OF SEDGWICK ss.
James C. Remsberg (employee of owner) or (owner or operator) of the above-described well, being first duly sworn on oath, says: That I have knowledge of the facts, statements, and matters herein contained and the log of the above-described well as filed and that the same are true and correct. So help me God.

(Signature) James C. Remsberg
JAMES C. REMSBERG, Oper. Mgr.
200 Douglas Building Wichita, Kansas 67202
(Address)

SUBSCRIBED AND SWORN TO before me this 23rd day of September, 1980

My commission expires 6/12/82

SHERRY L. KENDALL
STATE NOTARY PUBLIC
Sedgwick County, Kansas
My Appt. Exp. 6/12/82

Notary Public.

15-179-20566-00-00

WELL LOG

OPERATOR: DONALD C. SLAWSON & MURFIN DRILLING CO., INC.
200 DOUGLAS BUILDING
WICHITA, KANSAS 67202

LEASE: #1 Schlageck 'A'
100' W/ SW NE Sec. 25-8-30W
Sheridan County, Kansas

CONTRACTOR: SLAWSON DRILLING COMPANY, INC.
200 DOUGLAS BUILDING
WICHITA, KANSAS 67202

COMMENCED: August 5, 1980

COMPLETED: August 18, 1980

CASING: Surface - 8 5/8" @ 387' w/275 sx 60/40 poz

0 - 390	Surface
390 - 520	Shale
520 - 1505	Shale and sand
1505 - 2015	Shale and shells
2015 - 3606	Shale
3606 - 3915	Shale and lime
3915 - 3925	Lime
3925 - 3980	Shale and lime
3980 - 4017	Lime
4017 - 4146	Lime and shale
4146 - 4167	Lime
4167 - 4270	Lime and shale
4270 - 4277	Lime
4277 - 4287	Lime and shale
4287 - 4325	Lime
4325 - 4550	Lime and shale
4550	RTD

STATE OF KANSAS)
COUNTY OF SEDGWICK) SS.


I, James C. Remsberg, OF THE SLAWSON DRILLING COMPANY, INC.
UPON OATH STATE THAT THE ABOVE AND FOREGOING IS A TRUE AND CORRECT COPY OF THE
LOG OF THE #1 Schlageck 'A' TEST.

James C. Remsberg
JAMES C. REMSBERG, President

SUBSCRIBED AND SWORN TO BEFORE ME THIS 23rd DAY OF September, 1980

Sherry L. Kendall
SHERRY L. KENDALL, Notary Public

MY COMMISSION EXPIRES: 6/12/82

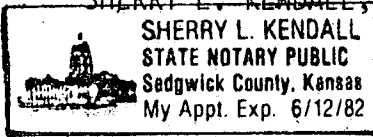

RECEIVED
STATE CORPORATION COMMISSION
SEP 24 1980
CONSERVATION DIVISION
Wichita, Kansas