


WELL PLUGGING RECORD

Give All Information Completely
Make Required Affidavit
Mail or Deliver Report to:
Conservation Division
State Corporation Commission
212 North Market, Insurance Bldg.
Wichita, Kansas

Sheridan County, Sec. 30 Twp. 8S Rge. 30W (W)

Location as "NE/CNW&SW¼" or footage from lines 440' FNL & 440' FEL, SE.
Lease Owner Wesselowski-Devlin Oil Operations
Lease Name Tillma Well No. #1
Office Address 217 East William, Wichita, KS 67202
Character of Well (completed as Oil, Gas or Dry Hole) Dry Hole
Date well completed March 2, 1982
Application for plugging filed Yes 19
Application for plugging approved 19
Plugging commenced 19
Plugging completed 2:40 A.M., March 2, 1982
Reason for abandonment of well or producing formation

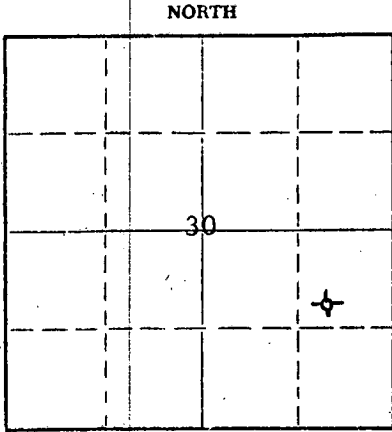

Locate well correctly on above Section Plat

If a producing well is abandoned, date of last production 19
Was permission obtained from the Conservation Division or its agents before plugging was commenced? Yes

Name of Conservation Agent who supervised plugging of this well Carl Goodrow
Producing formation Depth to top Bottom Total Depth of Well Feet
Show depth and thickness of all water, oil and gas formations.

OIL, GAS OR WATER RECORDS

CASING RECORD

FORMATION	CONTENT	FROM	TO	SIZE	PUT IN	PULLED OUT
				8-5/8"	317'	

Describe in detail the manner in which the well was plugged, indicating where the mud fluid was placed and the method or methods used in introducing it into the hole. If cement or other plugs were used, state the character of same and depth placed, from feet to feet for each plug set.

Plug #1 @ 1650' w/70 sxs.
Plug #2 @ 320' w/40 sxs.
Plug #3 @ 40' w/10 sxs.

10 sxs. in rathole


RECEIVED
STATE CORPORATION COMMISSION
03-10-1982
MAR 10 1982
CONSERVATION DIVISION
Wichita Kansas

(If additional description is necessary, use BACK of this sheet)
Name of Plugging Contractor John O. Farmer, Inc.
Address P.O. Box 352, Russell, KS 67665

STATE OF Kansas, COUNTY OF Russell, ss.
Sam Farmer (employee of owner) of the above-described well, being first duly sworn on oath, says: That I have knowledge of the facts, statements, and matters herein contained and the log of the above-described well as filed and that the same are true and correct. So help me God.

(Signature) Sam Farmer
P.O. Box 352, Russell, KS 67665
(Address)

Subscribed and sworn to before me this 8th day of March, 1982

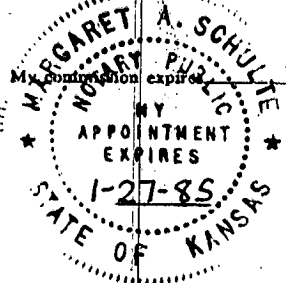

January 27, 1985
Margaret A. Schulte
Notary Public.