

15-065-20093-00-00

STATE OF KANSAS
STATE CORPORATION COMMISSION


Form CP-4

Give All Information Completely
Make Required Affidavit
Mail or Deliver Report to:
Conservation Division
State Corporation Commission
212 No. Market
Wichita, Kansas

WELL PLUGGING RECORD

Graham County. Sec. 3 Twp. 8S Rge. 25W (E) (W)
Location as "NE/CNWxSWx" or footage from lines C NW SW
Lease Owner Rock Island Oil & Refining Co., Inc.
Lease Name Sullivan Well No. 1
Office Address 321 West Douglas, Wichita, Kansas
Character of Well (completed as Oil, Gas or Dry Hole) D & A
Date well completed June 26 1967
Application for plugging filed June 26 1967
Application for plugging approved June 26 1967
Plugging commenced June 26 1967
Plugging completed June 26 1967
Reason for abandonment of well or producing formation D & A

NORTH

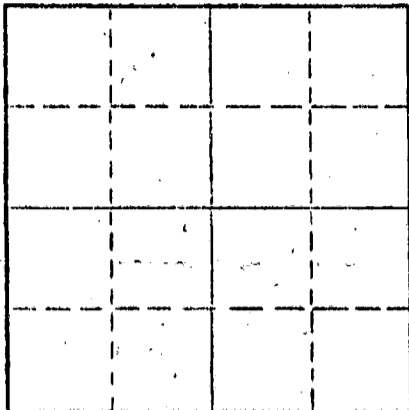

Locate well correctly on above
Section Plat

If a producing well is abandoned, date of last production 19
Was permission obtained from the Conservation Division or its agents before plugging was commenced? Yes

Name of Conservation Agent who supervised plugging of this well W. L. Nichols
Producing formation _____ Depth to top _____ Bottom _____ Total Depth of Well 399.3 Feet
Show depth and thickness of all water, oil and gas formations.

OIL, GAS OR WATER RECORDS

CASING RECORD

FORMATION	CONTENT	FROM	TO	SIZE	PUT IN	PULLED OUT
				8 5/8"	213'	- 0 -

Describe in detail the manner in which the well was plugged, indicating where the mud fluid was placed and the method or methods used in introducing it into the hole. If cement or other plugs were used, state the character of same and depth placed, from _____ feet to _____ feet for each plug set.

Fill hole with mud to 600'.
Plug & 18 sx cement. Mud to 210 - 1/2 sx hulls. Plug & 20 sx cement. Mud to 40'.
1/2 sx hulls. Plug & 10 sx cement. 2 sx cement in rathole.

RECEIVED
STATE CORPORATION COMMISSION

JUN 30 1967

CONSERVATION DIVISION
Wichita, Kansas

(If additional description is necessary, use BACK of this sheet)

Name of Plugging Contractor Red Tiger Drilling Co.
Address Box 173, Russell, Kansas

620-67

STATE OF KANSAS, COUNTY OF SEDGWICK, ss.
Maxine V. Starr (employee of owner) of the above-described well, being first duly sworn on oath, says: That I have knowledge of the facts, statements, and matters herein contained and the log of the above-described well as filed and that the same are true and correct. So help me God.

(Signature) Maxine V. Starr
1720 Wichita Plaza - Wichita, Kansas
(Address)

before me this 28th day of June, 1967



Betty M. Maloney Notary Public.

18-065-20053-00-00

DRILLERS LOG

Sullivan No. 1

SING RECORD: COMPANY: Rock Island Oil & Refining Co., Inc.
 5/8" @ 213' CONTRACTOR: Red Tiger Drilling Co. DESCRIPTION:
 160 sx cement COMMENCED: June 20, 1967 C NW SW
 3-88-25W
 COMPLETED: June 26, 1967 Graham Co., Ks.

TOTAL DEPTH: 3993'

ELEVATION:

<u>FORMATION</u>	<u>FROM</u>	<u>TO</u>	<u>REMARKS</u>
Clay & Sand	0	70	
Black Shale	70	110	
Blue Shale	110	214	
Shale	214	780	
Shale, Sand, & Shells	780	2155	
Shale	2155	2179	
Anhydrite	2179	2215	
Shale	2215	2510	
Shale & Shells	2510	3010	
Shale & Lime	3010	3400	
Lime	3400	3475	
Lime & Shale	3475	3599	
Lime	3599	3630	
Lime & Shale	3630	3740	
Lime	3740	3980	
Shale	3980	3993	

RECEIVED
 STATE CONSERVATION COMMISSION
 JUN 29 1967
 6-20-67
 CONSERVATION DIVISION
 Wichita, Kansas

I certify that this is a true and correct copy of the above log to the best of my knowledge.

RED TIGER DRILLING COMPANY

Maxine V. Starr
 Maxine V. Starr

Subscribed and sworn to before me this 28th day of June, 1967.

Betty M. Maloney
 Notary Public

My Commission Expires:

