


15-065-01011-00-00

WELL PLUGGING RECORD

Give All Information Completely  
Make Required Affidavit  
Mail or Deliver Report to:  
Conservation Division  
State Corporation Commission  
211 No. Broadway  
Wichita, Kansas

NORTH

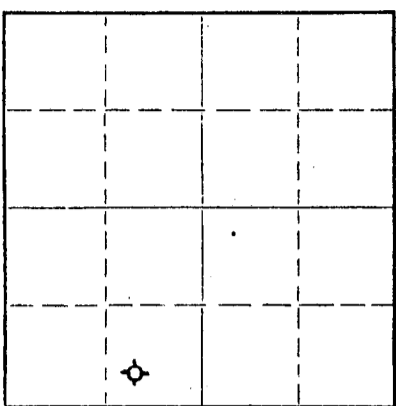

Locate well correctly on above Section Plat

Graham County. Sec. 5 Twp. 8 Rge. 25 (E) W (W)  
Location as "NE/CNW/SW" or footage from lines SW SE SW  
Lease Owner C-G Drilling Company  
Lease Name Toll Well No. 1  
Office Address 107 Rule Building, Wichita, Kansas  
Character of Well (completed as Oil, Gas or Dry Hole) Oil  
Date well completed March 4 1957  
Application for plugging filed December 5 1960  
Application for plugging approved December 5 1960  
Plugging commenced December 5 1960  
Plugging completed December 8 1960  
Reason for abandonment of well or producing formation Depleted reservoir

If a producing well is abandoned, date of last production: December 1 1960  
Was permission obtained from the Conservation Division or its agents before plugging was commenced? Yes

Name of Conservation Agent who supervised plugging of this well A. D. Frabricius  
Producing formation \_\_\_\_\_ Depth to top \_\_\_\_\_ Bottom \_\_\_\_\_ Total Depth of Well 4022 Feet  
Show depth and thickness of all water, oil and gas formations.

OIL, GAS OR WATER RECORDS

CASING RECORD

FORMATION	CONTENT	FROM	TO	SIZE	PUT IN	PULLED OUT
				8"	209'	None
				5"	4021'	1899'

Describe in detail the manner in which the well was plugged, indicating where the mud fluid was placed and the method or methods used in introducing it into the hole. If cement or other plugs were used, state the character of same and depth placed, from \_\_\_\_\_ feet to \_\_\_\_\_ feet for each plug set.

Plugged hole with sand from 3958 to 3940'.  
Dumped 4 sacks of cement on bridge.  
10 Foot rock bridge @ 207'.  
Filled hole with mud to 30'.  
Put 10 sacks of cement on top.

RECEIVED  
STATE CORP. COMMISSION  
DEC 22 1960  
CONSERVATION DIVISION  
Wichita, Kansas

12-22-60

(If additional description is necessary, use BACK of this sheet)  
Name of Plugging Contractor Pipe Pullers, Inc. Permit #462  
Address Box 486, Ellinwood, Kansas

STATE OF KANSAS, COUNTY OF BARTON, ss.  
Dean Wells (employee of owner) or (~~owner or agent~~) of the above-described well, being first duly sworn on oath, says: That I have knowledge of the facts, statements, and matters herein contained and the log of the above-described well as filed and that the same are true and correct. So help me God.

(Signature) Dean Wells  
Box 486, Ellinwood, Kansas  
(Address)

SUBSCRIBED AND SWORN to before me this 16th day of December, 1960  
I. J. Rader Notary Public.



15065-01011-00-00

WELL LOG

OPERATOR C-G Drilling Co. & N. Appleman Co.

SEC. 5-8-25W

WELL NAME Toll #1

LOC. SW SE SW

TOTAL DEPTH 4022'

COUNTY Graham

DRLG COMM. 2/16/57 WELL COMP. 3/4/57  
PLUGGING COMM. 12/5/60 PLUGGING COMP. 12/8/60  
RIG NO. 2

STATE Kansas

ELEVATION 2512' R.B.

CASING: Ran 209' (10 jts.) 8-5/8" OD Surface  
- Casing.  
Set 5-1/2" OD Casing @4021' (127 jts.)  
Pulled 1899'. Left 2122' in hole.

PRODUCTION: D & A

All measurements taken from the top of rotary bushing.

FROM	TO	FORMATION	DEVIATION FROM VERTICAL	REMARKS:
0	137	Shale-Shell		
137	157	Sand		
157	207	Blue Shale		
207	1400	Shale		
1400	1645	Sand-Shale		
1645	1720	Shale-Shell		
1720	2200	Red Bed		
2200	2230	Anhydrite		
2230	2265	Sand		
2265	2410	Red Bed		
2410	2790	Shale-Shell	0° - 2500	
2790	3150	Shale-Lime	0° - 2750	
3150	3772	Lime-Shale	0° - 3000	
3772	4022	Lime	0° - 3250	DST 3818-3826'
			0° - 3500	DST 3937-3955'
			0° - 3750	DST 3955-3977'
			0° - 4000	

RECEIVED  
STATE CONSERVATION COMMISSION

DEC 22 1960  
12-22-60  
CONSERVATION DIVISION  
Wichita, Kansas

STATE OF KANSAS }  
COUNTY OF SEDGWICK } SS.

The undersigned hereby certifies that to the best of his knowledge and belief, the above facts are true and correct.

C-G DRILLING CO.

By G. F. Galloway  
G. F. Galloway

G. F. Galloway

THIS 12th day of December, 1960.

Vicky Jacobs  
Vicky Jacobs - Notary public

