


STATE OF KANSAS
STATE CORPORATION COMMISSION

Give All Information Completely
Make Required Affidavit
Mail or Deliver Report to:
Conservation Division
State Corporation Commission
212 North Market, Insurance Bldg.
Wichita, Kansas

15-065-21038-06-00
WELL PLUGGING RECORD

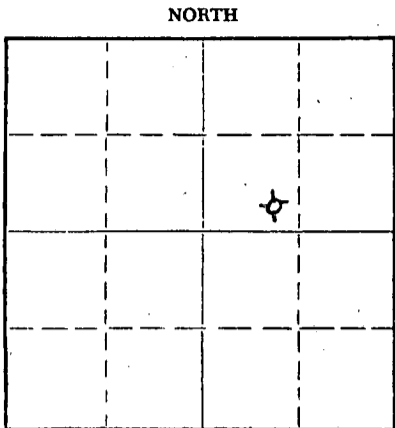

Locate well correctly on above Section Plat

Graham County. Sec. 7 Twp. 8S Rge. 25W (E) (W)
Location as "NE/CNW/SW" or footage from lines SE SW NE
Lease Owner John O. Farmer, Inc.
Lease Name Davis Well No. #1
Office Address Box 352 Russell, Kansas 67665
Character of Well (completed as Oil, Gas or Dry Hole) Dry Hole
Date well completed 7-17-78 19__
Application for plugging filed Yes 19__
Application for plugging approved 19__
Plugging commenced 19__
Plugging completed 7:00 p.m. 7-17-78 19__
Reason for abandonment of well or producing formation _____

If a producing well is abandoned, date of last production _____ 19__
Was permission obtained from the Conservation Division or its agents before plugging was commenced? Yes

Name of Conservation Agent who supervised plugging of this well Gilbert Balthazor
Producing formation _____ Depth to top _____ Bottom _____ Total Depth of Well _____ Feet
Show depth and thickness of all water, oil and gas formations.

OIL, GAS OR WATER RECORDS

CASING RECORD

FORMATION	CONTENT	FROM	TO	SIZE	PUT IN	PULLED OUT

Describe in detail the manner in which the well was plugged, indicating where the mud fluid was placed and the method or methods used in introducing it into the hole. If cement or other plugs were used, state the character of same and depth placed, from _____ feet to _____ feet for each plug set.

Plug #1 1050' w/70 sx. Cement
Plug #2 200' w/20 sx. Cement
Plug #3 40' w/10 sx. Cement

RECEIVED
STATE CORPORATION COMMISSION

JUL 19 1978

CONSERVATION DIVISION
Wichita, Kansas

7-19-78


(If additional description is necessary, use BACK of this sheet)
Name of Plugging Contractor John O. Farmer, Inc.
Address Box 352 Russell, Kansas 67665

STATE OF Kansas, COUNTY OF Russell, ss.
John O. Farmer (employee of owner) or (owner or operator) of the above-described

well, being first duly sworn on oath, says: That I have knowledge of the facts, statements, and matters herein contained and the log of the above-described well as filed and that the same are true and correct. So help me God.

(Signature) John O. Farmer
Box 352 Russell, Kansas 67665
(Address)

Subscribed and sworn to before me this 18th day of July, 1978

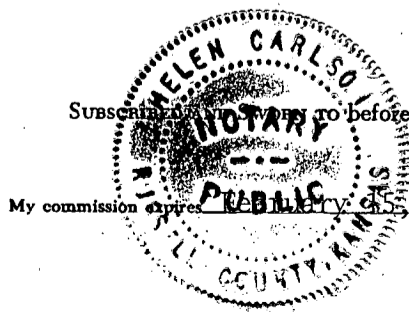

Helen Carlson Notary Public.