


15-065-02777-00-00

WELL PLUGGING RECORD

Give All Information Completely  
Make Required Affidavit  
Mail or Deliver Report to:  
Conservation Division  
State Corporation Commission  
212 North Market, Insurance Bldg.  
Wichita, Kansas

NORTH

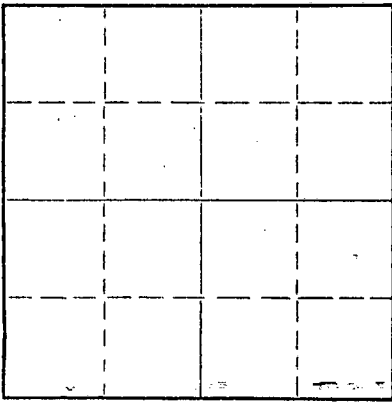

Locate well correctly on above  
Section Plat

Graham County. Sec. 8 Twp. 8 Rge. 25 (E) W (W)  
Location as "NE/CNW&SW" or footage from lines. SE/4 SE/4 SE/4  
Lease Owner Empire Drilling Co.,  
Lease Name Empire Drilling Co - Madden Davis Well No. C1  
Office Address Wichita, Kansas.  
Character of Well (completed as Oil, Gas or Dry Hole) Oil  
Date well completed 5-30-54 19 54  
Application for plugging filed \_\_\_\_\_ 19 \_\_\_\_\_  
Application for plugging approved \_\_\_\_\_ 19 \_\_\_\_\_  
Plugging commenced Aug 14 19 60  
Plugging completed Aug 16 19 60  
Reason for abandonment of well or producing formation \_\_\_\_\_  
Went to water  
If a producing well is abandoned, date of last production May 31, 19 60  
Was permission obtained from the Conservation Division or its agents before plugging was commenced? Yes

Name of Conservation Agent who supervised plugging of this well Fabrigius  
Producing formation Lansing K.C. Depth to top \_\_\_\_\_ Bottom \_\_\_\_\_ Total Depth of Well 3897 Feet  
Show depth and thickness of all water, oil and gas formations.

OIL, GAS OR WATER RECORDS

CASING RECORD

FORMATION	CONTENT	FROM	TO	SIZE	PUT IN	PULLED OUT
				176'	8 5/8"	None
				3892'	5 1/2"	2188'

Describe in detail the manner in which the well was plugged, indicating where the mud fluid was placed and the method or methods used in introducing it into the hole. If cement or other plugs were used, state the character of same and depth placed, from 3897 feet to surface feet for each plug set.

Top perforations at 3765, Hole filled with sand to 3760 ft; two sacks of cement placed on top of sand with dump bailer; hole then filled with sand to 3765; Wooden plug installed just above perforation and ~~XXXXXXXXXXXX~~ three sacks of cement placed on top of wooden plug with dump bailer; All pipe then pulled and hole filled with mud to 170 feet; ten foot rock bridge installed between 170 feet and 160 ft; twenty five sacks of cement poured into hole, and hole then filled with mud to 40 feet; ten foot rock bridge installed between 30 and 40 feet and hole capped with ten sacks of cement to bottom of cellar.

**RECEIVED**  
STATE CORPORATION COMMISSION

SEP 1 1960

CONSERVATION DIVISION  
Wichita, Kansas

Name of Plugging Contractor Barnes and Sons Pipe Pulling Co., Russell, Kansas.  
Address \_\_\_\_\_

STATE OF Kansas COUNTY OF Sedgwick ss. 9-1-60  
I, Dan J. Kornfeld (employee of owner) or (owner or operator) of the above-described well, being first duly sworn on oath, says: That I have knowledge of the facts, statements, and matters herein contained and the log of the above-described well as filed and that the same are true and correct. So help me God.

(Signature) Dan J. Kornfeld  
650 Fourth Nat'l Bank Bldg., Wichita, 2, Kans.  
(Address)

Subscribed and sworn to before me this 25th day of August, 19 60

My commission expires Oct 21, 1962

Lucille H. Harr  
Lucille H. Harr Notary Public.



15-065-02777-00-00

LOG

COMPANY: HARRY GORE  
 CONTRACTOR: EMPIRE DRILLING COMPANY  
 FARM: MADDEN-DAVIS "C"-1  
 LOCATION: SE SE SE, SEC. 8-8-25 W  
 GRAHAM COUNTY, KANSAS  
 COMMENCED: 5-22-54  
 COMPLETED: 5-30-54

0	TO	189	SURFACE HOLE
189	TO	285	SHALE
285	TO	1300	SHALE AND SAND
1300	TO	1700	SHALE, SHELLS AND SAND
1700	TO	2140	SHALE
2140	TO	2170	ANHYDRITE
2170	TO	2225	SHALE
2225	TO	2480	SHALE AND SHELLS
2480	TO	2635	SHALE AND LIME
2635	TO	2815	SHALE
2815	TO	3080	SHALE AND LIME
3080	TO	3295	LIME
3295	TO	3480	LIME AND SHALE
3480	TO	3600	SHALE AND LIME
3600	TO	3700	LIME AND SHALE
3700	TO	3899	LIME
3899			R.T.D.

**RECEIVED**  
 STATE CORPORATION COMMISSION  
 SEP 1 1960  
 CONSERVATION DIVISION  
 Wichita, Kansas

SET 176' OF 8-5/8" SURFACE CASING, CEMENTED WITH 110 SACKS OF CEMENT.

9-1-60

ELEVATION: 2445 K.B.

TOPS: HEEBNER 3694'; TORONTO 3714'; L.S. K.C. 3726'; R.T.D. 3899'.

RAN 3892' 5 1/2" CASING, CEMENTED WITH 75 SACKS OF CEMENT.

C E R T I F I C A T I O N

I, DAN J. KORNFELD, DO HEREBY CERTIFY THAT THE ABOVE AND FOREGOING IS A TRUE AND CORRECT COPY OF THE LOG ON THE MADDEN-DAVIS "C"-1, SE SE SE, SECTION 8, TOWNSHIP 8, RANGE 25 WEST, GRAHAM COUNTY, KANSAS, AS REFLECTED BY THE FILES OF THE EMPIRE DRILLING COMPANY.

*Dan J. Kornfeld*  
 \_\_\_\_\_  
 DAN J. KORNFELD

SUBSCRIBED AND SWORN TO BEFORE ME A NOTARY PUBLIC WITHIN AND FOR SEDGWICK COUNTY, KANSAS THIS 15TH DAY OF JUNE 1954.

MY COMMISSION EXPIRES MAY 5, 1956

*Mary Zimmerman*  
 \_\_\_\_\_  
 NOTARY PUBLIC