

15-065-02778-00-00


STATE OF KANSAS
STATE CORPORATION COMMISSION

WELL PLUGGING RECORD

Give All Information Completely
Make Required Affidavit
Mail or Deliver Report to:
Conservation Division
State Corporation Commission
211 No. Broadway
Wichita, Kansas

Graham County. Sec. 8 Twp. 8 Rge. 25 (E) (W) X

NORTH

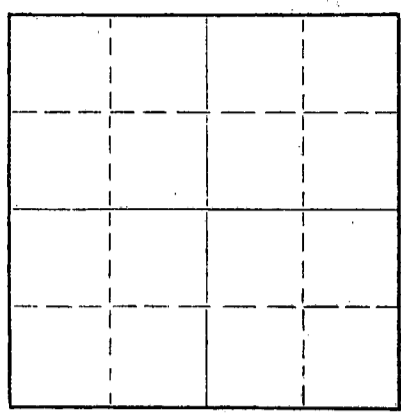

Locate well correctly on above
Section Plat

Location as "NE/CNW/SW" or footage from lines SE SW SE
Lease Owner Empire Drilling Company
Lease Name Madden Davis C Well No. 2
Office Address 650 Fourth National Bank Building, Wichita, Ks.
Character of Well (completed as Oil, Gas or Dry Hole) Oil well
Date well completed June 27, 1954 19
Application for plugging filed May 24, 1960 19
Application for plugging approved May 24, 1960 19
Plugging commenced May 24, 1960 19
Plugging completed May 26, 1960 19
Reason for abandonment of well or producing formation Went to water

If a producing well is abandoned, date of last production May 14, 1960
Was permission obtained from the Conservation Division or its agents before plugging was commenced? yes

Name of Conservation Agent who supervised plugging of this well A. D. Fabricius
Producing formation Lansing-Kansas City Depth to top 3882 Bottom 3882 Total Depth of Well 3882 Feet
Show depth and thickness of all water, oil and gas formations.

OIL, GAS OR WATER RECORDS

CASING RECORD

FORMATION	CONTENT	FROM	TO	SIZE	PUT IN	PULLED OUT
	Surface	0	180	8 5/8"	174'	-0-
	Lime	3725	3882	5 1/2"	3872'	1175.30'

Describe in detail the manner in which the well was plugged, indicating where the mud fluid was placed and the method or methods used in introducing it into the hole. If cement or other plugs were used, state the character of same and depth placed, from 3882 feet to surface feet for each plug set.
Welex plug set at 3810 with top perforation at 3782. Hole filled with sand to 3770. 5 sacks cmenet dumped with dump bailer on bottom. Pipe shot off at 1175'. All pulled above 1175'. Hole filled with mud to 170'. 5' rock bridge placed between 170' and 165' and 25 sacks cement poured in hole. Hole then mudded up to 40'. 10' rock bridge installed between 30' and 40' and hole capped with 10 sacks of cement to bottom of cellar.

RECEIVED
STATE CORPORATION COMMISSION
JUN 15 1960
CONSERVATION DIVISION
Wichita, Kansas

(If additional description is necessary, use BACK of this sheet)
Name of Plugging Contractor Barnes & Sons Pipe Pulling Company 6-15-60
Address Russell, Kansas

STATE OF KANSAS, COUNTY OF SEDGWICK, ss.
Irwin Kornfeld (employee of owner) or (owner or operator) of the above-described well, being first duly sworn on oath, says: That I have knowledge of the facts, statements, and matters herein contained and the log of the above-described well as filed and that the same are true and correct. So help me God.

(Signature) Irwin Kornfeld
650-4th Nat'l. Bank Bldg., Wichita, Kansas
(Address)



SUBSCRIBED AND SWORN to before me this 14th day of June, 1960
Lucille H. Harr
Notary Public.

COMPANY: HARRY CORN
 CONTRACTOR: EMPIRE DRILLING COMPANY
 FARM: MADDEN-DAVIS C-2
 LOCATION: SE SW SE, SEC. 6-0-25
 GRAHAM COUNTY, KANSAS
 COMMENCED: 6-19-54
 COMPLETED: 6-27-54

0	TO	100	SURFACE HOLE
100	TO	840	SHALE
840	TO	1470	SHALE AND SAND
1470	TO	1890	SHALE AND SHELLS
1890	TO	2117	SHALE
2117	TO	2150	ANHYDRITE
2150	TO	2590	SHALE AND SHELLS
2590	TO	2725	LIME AND SHALE
2725	TO	3020	SHALE AND LIME
3020	TO	3170	LIME
3170	TO	3235	LIME AND SHALE
3235	TO	3315	LIME
3315	TO	3500	LIME AND SHALE
3500	TO	3565	LIME
3565	TO	3725	LIME AND SHALE
3725	TO	3882	LIME
3882			R.T.D.

SET 174' OF 8-5/8" SURFACE CASING, CEMENTED WITH 110 SACKS OF CEMENT.
 ELEVATION: 2428 K.F.
 TOPS: HEEBNER 3671'; TORONTO 3693'; L.S. K.C. 3703'; R.T.D. 3882'.
 SET 2672' - 5 1/2" CASING, CEMENTED WITH 75 SACKS OF CEMENT.

C E R T I F I C A T I O N

I, DAN J. KORNFIELD, DO HEREBY CERTIFY THAT THE ABOVE AND FOREGOING IS A TRUE AND CORRECT COPY OF THE LOG ON THE MADDEN-DAVIS C-2, SE SW SE, SECTION 6, TOWNSHIP 8, RANGE 25 WEST, GRAHAM COUNTY, KANSAS AS REFLECTED BY THE FILES OF THE EMPIRE DRILLING COMPANY.

DAN J. KORNFIELD

SUBSCRIBED AND SWORN TO BEFORE ME A NOTARY PUBLIC WITHIN AND FOR SEDGWICK COUNTY, KANSAS THIS 6TH DAY OF JULY 1954.

MY COMMISSION EXPIRES MAY 5, 1956

Mary Kammer
 NOTARY PUBLIC

RECEIVED
 STATE CORPORATION COMMISSION

JUN 15 1960

6-15-60

CONSERVATION DIVISION
 Wichita, Kansas