

15-065-20321-00-00


STATE OF KANSAS  
STATE CORPORATION COMMISSION

Form CP-4

Give All Information Completely  
Make Required Affidavit  
Mail or Deliver Report to:  
Conservation Division  
State Corporation Commission  
211 No. Broadway  
Wichita, Kansas

WELL PLUGGING RECORD

NORTH

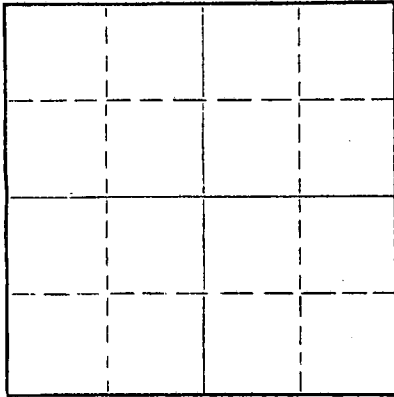

Locate well correctly on above  
Section Plat

Graham County, Sec. 9 Twp. 8S Rge. 25 (~~EX~~ W (W))  
Location as "NE/CNW/SW" or footage from lines 440' W of EL & 440' S of NL  
Lease Owner Empire Drilling Company  
Lease Name Graham County Well No. 1  
Office Address 650 Fourth National Bank Building, Wichita, Kansas  
Character of Well (completed as Oil, Gas or Dry Hole) Dry Hole  
Date well completed May 7 19 70  
Application for plugging filed May 7 19 70  
Application for plugging approved May 7 19 70  
Plugging commenced May 8 19 70  
Plugging completed May 8 19 70  
Reason for abandonment of well or producing formation No producible zone.

If a producing well is abandoned, date of last production \_\_\_\_\_ 19 \_\_\_\_  
Was permission obtained from the Conservation Division or its agents before plugging was commenced? Yes

Name of Conservation Agent who supervised plugging of this well W. L. Nichols  
Producing formation \_\_\_\_\_ Depth to top \_\_\_\_\_ Bottom \_\_\_\_\_ Total Depth of Well 3952 Feet  
Show depth and thickness of all water, oil and gas formations.

OIL, GAS OR WATER RECORDS

CASING RECORD

FORMATION	CONTENT	FROM	TO	SIZE	PUT IN	PULLED OUT
				8 5/8	175	0

Describe in detail the manner in which the well was plugged, indicating where the mud fluid was placed and the method or methods used in introducing it into the hole. If cement or other plugs were used, state the character of same and depth placed, from \_\_\_\_\_ feet to \_\_\_\_\_ feet for each plug set.

Gunned up pits forming heavy mud and filled hole to 1075 feet. Spotted 100 sacks cement through drill pipe. Filled hole up to 185 feet. Spotted 25 sacks cement through drill pipe. Filled hole up to 40 feet with heavy mud and cemented with 10 sacks to base of Well Cellar. Job complete at 8:00 AM, May 8, 1970.

RECEIVED  
STATE CORPORATION COMMISSION  
MAY 25 1970  
CONSERVATION DIVISION  
Wichita, Kansas

(If additional description is necessary, use BACK of this sheet)

5-25-70

Name of Plugging Contractor Garvey Drilling Company  
Address Box 1164, Great Bend, Kansas 67530


STATE OF Kansas, COUNTY OF Barton, ss.  
Verne A. Morris (employee of owner), or (owner or operator) of the above-described

well, being first duly sworn on oath, says: That I have knowledge of the facts, statements, and matters herein contained and the log of the above-described well as filed and that the same are true and correct. So help me God.

(Signature) Verne A. Morris  
Box 1164, Great Bend, Kansas 67530  
(Address)

SUBSCRIBED AND SWORN to before me this 21st day of May, 19 70

My commission expires November 5, 1973

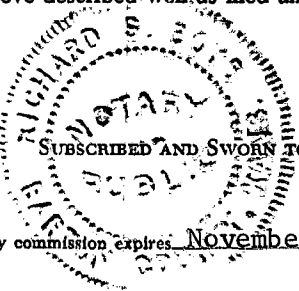


Richard D. Coey  
Notary Public

15-065-20321-0000

# WELL LOG

COMPANY Empire Drilling Company  
 FARM Graham County NO. 1  
 TOTAL DEPTH 3952'  
 COMM. 4-30-70 COMP. 5- 8-70  
 CONTRACTOR Garvey Drilling Company

SEC. 9 T. 8S R. 25W  
 LOC. C NE NE NE  
 COUNTY Graham, Kansas

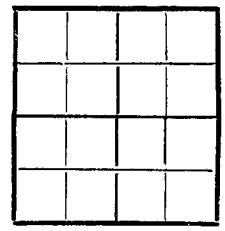

CASING  
 8 5/8" @ 175' w/160sx

ELEVATION  
 PRODUCTION D & A

FIGURES INDICATE BOTTOM OF FORMATIONS


- 100' Clay & Shells
- 130' Clay, Shale, & Sand
- 175' Blue Shale
- 650' Shale & Shells
- 1880' Sand
- 1975' Shale
- 2151' Anhydrite
- 2305' Shale
- 2655' Shale & Lime Streaks
- 2775' Shale & Lime
- 3010' Lime & Shale
- 3800' Lime
- 3910' Lime & Shale
- 3952' Lime & Shale
- 3952' RTD

RECEIVED  
 STATE CORPORATION COMMISSION  
 MAY 25 1970  
 CONSERVATION DIVISION  
 Wichita, Kansas  
 5-25-70

State of Kansas }  
 County of Barton } ss

I, Charlene Marker of Garvey Drilling Company

upon oath state the above and foregoing is a true and correct copy of the log of the Graham County No. 1 well.

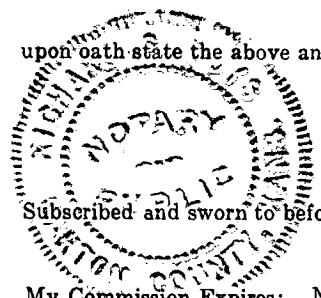

Charlene Marker

Subscribed and sworn to before me this 11th day of May 1970

My Commission Expires: November 5, 1973

Richard S. Depp  
 NOTARY PUBLIC