


STATE OF KANSAS  
STATE CORPORATION COMMISSION

Give All Information Completely  
Make Required Affidavit  
Mail or Deliver Report to:  
Conservation Division  
State Corporation Commission  
800 Biting Building  
Wichita, Kansas

15-065-0220a-00-00  
WELL PLUGGING RECORD

NORTH

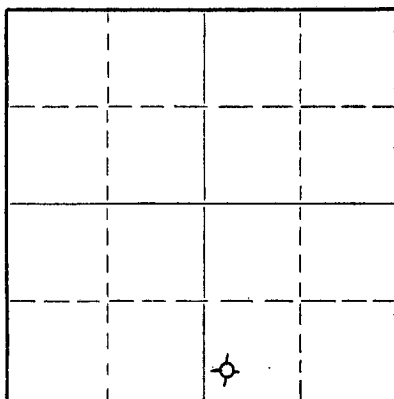

Locate well correctly on above  
Section Plat

Graham County. Sec. 16 Twp. 8 Rge. 25 (E) W (W)  
Location as "NE/CNW/SW" or footage from lines SW SW SE  
Lease Owner C-G DRILLING CO.  
Lease Name LUNNEY Well No. 1  
Office Address 544 Petroleum Bldg., Wichita, Kansas  
Character of Well (completed as Oil, Gas or Dry Hole) Dry Hole  
Date well completed March 22, 1953  
Application for plugging filed March 22, 1953  
Application for plugging approved March 22, 1953  
Plugging commenced March 22, 1953  
Plugging completed March 22, 1953  
Reason for abandonment of well or producing formation Too low structurally

If a producing well is abandoned, date of last production \_\_\_\_\_ 19\_\_\_\_  
Was permission obtained from the Conservation Division or its agents before plugging was commenced? yes

Name of Conservation Agent who supervised plugging of this well Eldon Petty  
Producing formation \_\_\_\_\_ Depth to top \_\_\_\_\_ Bottom \_\_\_\_\_ Total Depth of Well 3968 Feet  
Show depth and thickness of all water, oil and gas formations.

OIL, GAS OR WATER RECORDS

CASING RECORD

FORMATION	CONTENT	FROM	TO	SIZE	PUT IN	PULLED OUT
				8 5/8"	170.58'	

Describe in detail the manner in which the well was plugged, indicating where the mud fluid was placed and the method or methods used in introducing it into the hole. If cement or other plugs were used, state the character of same and depth placed, from \_\_\_\_\_ feet to \_\_\_\_\_ feet for each plug set.

Filled hole with mud to 165'; set plug; 1/2 sack hulls; 15 sacks cement. Filled hole with mud to 40'; set plug; then filled to top with 10 sacks cement and 1/2 sack hulls.

(If additional description is necessary, use BACK of this sheet)  
Name of Plugging Contractor Lohmann-Johnson Drilling Company, Inc.  
Address 320 Indiana Bank Building, Evansville 8, Indiana

STATE OF KANSAS, COUNTY OF SEDGWICK, ss.  
Vicky Jacobs (employee of owner) or (~~owner~~) of the above-described well, being first duly sworn on oath, says: That I have knowledge of the facts, statements, and matters herein contained and the log of the above-described well as filed and that the same are true and correct. So help me God.

(Signature) Vicky Jacobs  
544 Petroleum Bldg., Wichita, Kansas  
(Address)

SUBSCRIBED AND SWORN TO before me this 23rd day of March, 1953

My commission expires November 21, 1955

Marilyn Schmidt Notary Public.



**PLUGGING**  
FILE SEC 16 T 8 R 25 W  
BOOK PAGE 86 UNIT 22

**RECEIVED**  
STATE CORPORATION COMMISSION  
MAR 25 1953 3/25/53  
CONSERVATION DIVISION

15-065-02200-0000

CONTRACTOR'S WELL LOG

OPERATOR C-G DRILLING CO. FARM NAME LUNNEY #1

LOCATION SW SW SE Sec. 16-8-25W

POOL NAME Schmeid COUNTY Graham STATE Kansas

COMMENCEMENT DATE March 13, 1953 COMPLETION DATE March 22, 1953

LOG OF WELL

Elevation: 2302 R.B.  
All measurements from the top of rotary bushing.

FROM	TO	FORMATION	DEVIATION FROM VERTICAL
0	155	Sand-Shale	
155	557	Shale-Shells	
557	1420	Shale-Sand-Shells	
1420	2065	Red Bed	0° - 1500'
2065	2105	Anhydrite	0° - 2000'
2105	2316	Shale-Shells	
2316	2580	Shale	0° - 2500'
2580	2714	Shale-Shells	
2714	2917	Shale-Shells	
2917	3029	Shale-Lime	0° - 3000'
3029	3110	Lime-Shale	
3110	3216	Lime-Shale	
3216	3325	Lime-Shale	
3325	3410	Lime-Shale	
3410	3538	Lime-Shale	0° - 3500'
3538	3632	Lime-Shale	
3632	3670	Lime	
3670	3687	Lime	
3687	3735	Lime-Shale	
3735	3786	Lime	
3786	3790	Lime	
3790	3840	Lime	
3840	3899	Lime-Shale	
3899	3955	Lime	
3955	3968	Lime	

CASING LEFT IN HOLE AFTER COMPLETION

Ran 170.58' (8 jts) 8 5/8" OD Casing.

STATE OF KANSAS, COUNTY OF SEDGWICK ) ss.

The undersigned certifies that to the best of her knowledge and belief, the above facts are true and correct.


C-G DRILLING CO.

By Vicky Jacobs

Subscribed and sworn to before me this 23rd day of March, 1953.

My commission expires: 11/21/55

Marilyn Schmidt  
Notary Public

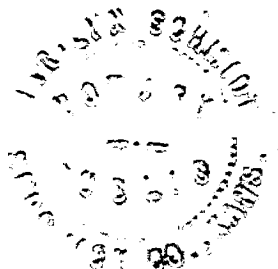

PLUGGING  
FILE SEC 16 T 8 R 25 W  
BOOK PAGE 86 LINE 22

STATE CORREC

3/25/53

CO