


STATE OF KANSAS
STATE CORPORATION COMMISSION

Give All Information Completely
Make Required Affidavit
Mail or Deliver Report to:
Conservation Division
State Corporation Commission
211 No. Broadway
Wichita, Kansas

WELL PLUGGING RECORD

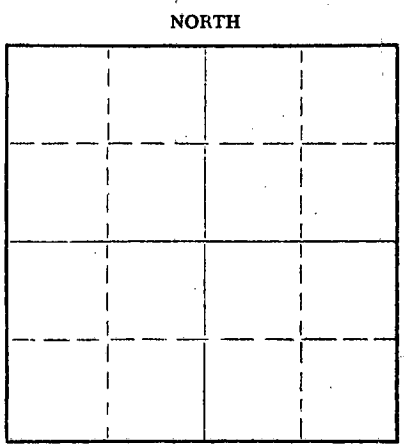

Graham County. Sec. 31 Twp. 8 Rge. (E) 24 (W)
Location as "NE/CNWxSWx" or footage from lines SE SW NE
Lease Owner I. W. Siegel, et al
Lease Name Keith Well No. 3
Office Address 1712 E. Morris, Wichita, Kansas
Character of Well (completed as Oil, Gas or Dry Hole) Dry Hole
Date well completed April 16, 19 57
Application for plugging filed April 16, 19 57
Application for plugging approved April 16, 19 57
Plugging commenced April 16, 19 57
Plugging completed April 16, 19 57
Reason for abandonment of well or producing formation _____

If a producing well is abandoned, date of last production _____ 19____
Was permission obtained from the Conservation Division or its agents before plugging was commenced? Yes

Name of Conservation Agent who supervised plugging of this well Eldon Petty
Producing formation _____ Depth to top _____ Bottom _____ Total Depth of Well 3965 Feet
Show depth and thickness of all water, oil and gas formations.

OIL, GAS OR WATER RECORDS

CASING RECORD

FORMATION	CONTENT	FROM	TO	SIZE	PUT IN	PULLED OUT
				8-5/8"	240'	

Describe in detail the manner in which the well was plugged, indicating where the mud fluid was placed and the method or methods used in introducing it into the hole. If cement or other plugs were used, state the character of same and depth placed, from _____ feet to _____ feet for each plug set.

Filled hole with heavy mud to 235'. Set Halliburton plug with 1/2 sack hulls and 20 sacks cement. Filled hole with mud to 40'. Set Halliburton plug with 1/2 sack hulls and 10 sacks cement to bottom of cellar.

(If additional description is necessary, use BACK of this sheet)

Name of Plugging Contractor Sterling Drilling Company
Address Sterling, Kansas

STATE OF KANSAS, COUNTY OF RICE, ss.
F. A. Wuellner (employee of owner) or (owner or operator) of the above-described well, being first duly sworn on oath, says: That I have knowledge of the facts, statements, and matters herein contained and the log of the above-described well as filed and that the same are true and correct. So help me God.


(Signature) F. A. Wuellner
Sterling, Kansas
(Address)

SUBSCRIBED AND SWORN TO before me this 17th day of April, 19 57

My commission expires Jan. 22, 1958

My commission expires _____

Bernard Landermilch
Notary Public.

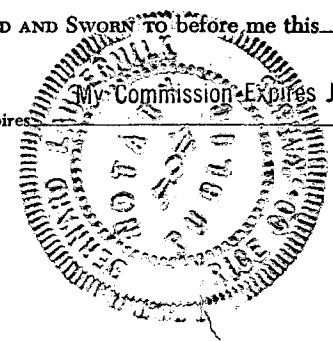

RECEIVED
STATE CORPORATION COMMISSION
4-19-1957
APR 19 1957

PLUGGING
FILE SEC. 31 T. 8 R. 24W
BOOK PAGE 7 LINE 25
CONSERVATION DIVISION
Wichita, Kansas

15-065-02231-00-00

STERLING DRILLING COMPANY
Sterling, Kansas

WELL LOG-----KEITH #3

Location: SE SW NE, Section 31-8S-24W,
Graham County, Kansas

OWNER: I. W. Siegel, et al
ROTARY DRILLING CONTRACTOR: Sterling Drilling Company

COMMENCED: 3-31-57 (w.r.)
COMPLETED: 4-16-57 (w.r.)

TOTAL DEPTH: 3965'

LOG

0-700	Shale	
700-1430	Shale & Sand	
1430-2175	Shale	
2175-2220	Anhydrite	
2220-2630	Shale	
2630-2830	Shale & Shells	
2830-2870	Shale	
2870-3060	Shale & Shells	
3060-3205	Shale & Limestone	
3205-3335	Limestone	
3335-3555	Shale & Limestone	
3555-3965	Limestone	T.D.

CASING RECORD

Set 8-5/8" casing at 240' with 175 sacks cement.

PRODUCTION

Plugged & Abandoned

PLUGGING			
FILE	SEC. 31	T. 9	R. 24W
BOOK	PAGE 7	LINE	25

RECEIVED
STATE CORPORATION COMMISSION
4-19-1957
APR 19 1957
CONSERVATION DIVISION
Wichita, Kansas