


15-065-00414-00-08

WELL PLUGGING RECORD

Give All Information Completely
Make Required Affidavit
Mail or Deliver Report to:
Conservation Division
State Corporation Commission
800 Bitting Building
Wichita, Kansas

NORTH

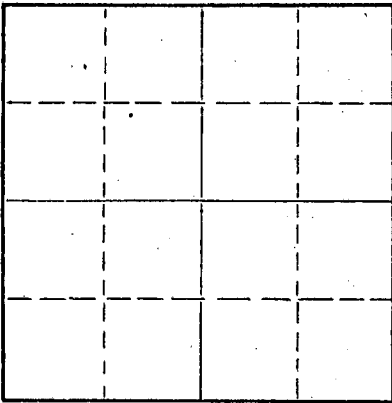

Locate well correctly on above
Section Plat

GRAHAM County, Sec. 10 Twp. 8 Rge. 25 (E) W (W)

Location as "NE/CNW/SW" or footage from lines NE NE NE
Lease Owner EMPIRE DRILLING COMPANY
Lease Name FOLTZ Well No. 1
Office Address 407 BROWN BLDG., WICHITA 2, KANSAS
Character of Well (completed as Oil, Gas or Dry Hole) DRY HOLE
Date well completed 11/18 19 54
Application for plugging filed 11/18 19 54
Application for plugging approved 11/18 19 54
Plugging commenced 11/18 19 54
Plugging completed 11/18 19 54
Reason for abandonment of well or producing formation DRY HOLE

If a producing well is abandoned, date of last production 19
Was permission obtained from the Conservation Division or its agents before plugging was commenced? YES

Name of Conservation Agent who supervised plugging of this well ELDON PETTY
Producing formation Depth to top Bottom Total Depth of Well 3980 Feet
Show depth and thickness of all water, oil and gas formations.

OIL, GAS OR WATER RECORDS

CASING RECORD


FORMATION	CONTENT	FROM	TO	SIZE	PUT IN	PULLED OUT
SURFACE	PIPE	0	167'	8-5/8"	167'	●

Describe in detail the manner in which the well was plugged, indicating where the mud fluid was placed and the method or methods used in introducing it into the hole. If cement or other plugs were used, state the character of same and depth placed, from feet to feet for each plug set.

SET BOTTOM PLUG AT 160', 1/2 SACK OF HULLS,
CEMENTED WITH 15 SACKS OF CEMENT.
SET TOP PLUG AT 40', 1/2 SACK OF HULLS,
CEMENTED WITH 10 SACKS OF CEMENT.

(If additional description is necessary, use BACK of this sheet)
Name of Plugging Contractor EMPIRE DRILLING COMPANY
Address 407 BROWN BLDG., WICHITA, KANSAS

STATE OF KANSAS, COUNTY OF SEDGWICK, ss. DAN J. KORNFELD, ~~employee of owner~~ owner (or operator) of the above-described well, being first duly sworn on oath, says: That I have knowledge of the facts, statements, and matters herein contained and the log of the above-described well as filed and that the same are true and correct. So help me God.
(Signature) Dan J. Kornfeld
DAN J. KORNFELD
407 BROWN BLDG., WICHITA, 2, KANSAS (Address)

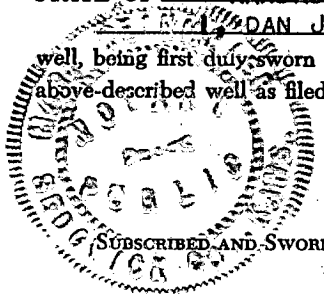

SUBSCRIBED AND SWORN to before me this 23 day of NOVEMBER, 19 54
Mary Steinmeier Notary Public.
My commission expires MAY 5, 1956

PLUGGING
FILE SEC 10 T 8 R 25W
BOOK PAGE 28 LINE 44

11/20/54

L O G

COMPANY: EMPIRE DRILLING COMPANY
 CONTRACTOR: EMPIRE DRILLING COMPANY
 FARM: FOLTZ #1
 LOCATION: NE NE NE, SEC. 10-8-25
 GRAHAM COUNTY, KANSAS
 COMMENCED: 11/7/54
 COMPLETED: 11/18/54

0	TO	40	SURFACE CLAY AND SHALE
40	TO	185	SURFACE HOLE
185	TO	1400	SHALE AND SAND
1400	TO	1740	SHALE, SAND AND SHELLS
1740	TO	2160	SHALE AND SHELLS
2160	TO	2162	SHALE
2162	TO	2196	ANHYDRITE
2196	TO	2530	SHALE AND SHELLS
2530	TO	2905	SHALE AND LIME
2905	TO	3035	SHALE
3035	TO	3220	SHALE AND LIME
3220	TO	3390	LIME AND SHALE
3390	TO	3455	SHALE AND LIME
3455	TO	3540	LIME AND SHALE
3540	TO	3630	LIME
3630	TO	3700	LIME AND SHALE
3700	TO	3980	LIME
3980			R.T.D.

SET 167' OF 8-5/8" SURFACE CASING, CEMENTED WITH 115 BAGS OF CEMENT.

ELEVATION: 2425 K. B.

TOPS: ANHYDRITE 2162'; HEEBNER 3708'; L.S. K. C. 3748'; BASE OF K.C. 3960';
 R.T.D. 3980'.

D & A

C E R T I F I C A T I O N

I, DAN J. KORNFELD, DO HEREBY CERTIFY THAT THE ABOVE AND FOREGOING IS A TRUE AND CORRECT COPY OF THE LOG ON THE FOLTZ #1, NE NE NE, SECTION 10, TOWNSHIP 8, RANGE 25 WEST, GRAHAM COUNTY, KANSAS AS REFLECTED BY THE FILES OF THE EMPIRE DRILLING COMPANY.

Dan J. Kornfeld
 DAN J. KORNFELD

SUBSCRIBED AND SWORN TO BEFORE ME A NOTARY PUBLIC WITHIN AND FOR SEDGWICK COUNTY, KANSAS THIS 23 DAY OF NOVEMBER 1954.

MY COMMISSION EXPIRES MAY 5, 1956

Mary Steiner
 NOTARY PUBLIC

PLUGGING
 FILE SEC 10 T 8 R 25W
 BOOK PAGE 38 LINE 44