

AFFIDAVIT AND COMPLETION FORM

ACO-1

This form must be filed in triplicate with the Kansas Corporation Commission, 200 Colorado Derby Building, Wichita, Kansas 67202, within five days after the completion of the well, regardless of how the well was completed. Circle one: Oil, gas, dry, SWD, OWWO, injection. Please type. Complete ALL sections. Applications must be filed for dual completion, commingling, salt water disposal and injection. Attach wireline logs (i.e. electrical log, sonic log, gamma ray neutron log, etc.) KCC#-(316) 263-3238.

00-00

OPERATOR Industrial Gas Services, Inc. API NO. 15-065-21633

ADDRESS 4501 Wadsworth Blvd. COUNTY Graham  
Wheat Ridge, CO 80033 FIELD Wildcat

\*\*CONTACT PERSON Robert M. Richardson LEASE Toll

PHONE (303)422-3400

PURCHASER \_\_\_\_\_ WELL NO. 1-8

ADDRESS \_\_\_\_\_ WELL LOCATION \_\_\_\_\_

DRILLING CONTRACTOR Emphasis Oil Operations 2338 Ft. from North Line and  
 2210 Ft. from East Line of  
 the SEC. 8 TWP. 85 RGE. 25W

ADDRESS P. O. Box 506  
Russell, Kansas 67665


PLUGGING CONTRACTOR Emphasis (job by Halliburton)

ADDRESS Same as above

TOTAL DEPTH 4020' PBD 4020'

SPUD DATE 5/16/82 DATE COMPLETED 5/25/82

ELEV: GR 2481 DF 2485 KB 2486

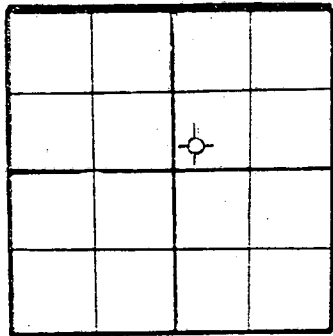

WELL PLAT  
 (Quarter) or (Full) Section - Please indicate.

DRILLED WITH ~~CABLE~~ (ROTARY) ~~WIRE~~ TOOLS  
 Report of all strings set — surface, intermediate, production, etc. (New) / (Used) casing.

Purpose of string	Size hole drilled	Size casing set (in O.D.)	Weight lbs/H.	Setting depth	Type cement	Sacks	Type and percent additives
Surface	12 1/4	8 5/8	28	261	Common	150	3% CaCl, 2% gel

LINER RECORD			PERFORATION RECORD		
Top, ft.	Bottom, ft.	Sacks cement	Shots per ft.	Size & type	Depth interval
-----NONE-----	-----				
TUBING RECORD					
Size	Setting depth	Packer set at			
	NONE				

ACID, FRACTURE, SHOT, CEMENT SQUEEZE RECORD	
Amount and kind of material used	Depth interval treated
NONE	

TEST DATE	PRODUCTION
Date of first production <u>Dry Hole</u>	Producing method: <u>flowing, pumping, gas lift, etc.</u>
	A.P.I. Gravity
RATE OF PRODUCTION PER 24 HOURS	Gas-oil ratio
Oil _____ bbls	Gas _____ MCF
Water _____ bbls	CFPB _____
Disposition of gas (vented, used, lease or sold)	Producing interval(s)

\*\* The person who can be reached by phone regarding any questions concerning this information. A witnessed initial test by the Commission is required if the well produces more than 25 BOPD or is located in a Basic Order Pool.

RECEIVED  
 STATE CORPORATION COMMISSION  
 JUN - 1 1982  
 CONSERVATION DIVISION  
 Wichita Kansas  
 6-1-82

Name of lowest fresh water producing stratum N/A Depth 200'  
 Estimated height of cement behind pipe Surface

**WELL LOG**

Show all important zones of porosity and contents thereof; cored intervals, and all drill-stem tests, including depth interval tested, cushion used, time tool open, flowing and shut-in pressures, and recoveries.

SHOW GEOLOGICAL MARKERS, LOGS RUN, OR OTHER DESCRIPTIVE INFORMATION.

FORMATION DESCRIPTION, CONTENTS, ETC.	TOP	BOTTOM	NAME	DEPTH
DST #1 - Recovered 10' OCM (15% oil) open 15, SI 60, open 30, SI 60 IHP 2054, IFP 49-49, ISIP 980 FFP 49-49, FSIP 833, FHP 2029	3833	3871	Stone Corral Topeka Heebner Toronto	2178 3523 3738 3762
DST #2 - Recovered 25' MCSW w/oil specks 5' drlg mud open 15, SI 60, Open 30, SI 60 IHP 2080, IFP 49-49, ISIP 1077 FFP 59-59, FSIP 1077 FHP 2504	3880	3936	Lansing/ Kansas City  TD	3779  4020
DST #3 - Recovered 40' SOCM, open 15 SI 60, open 60, SI 180 IFP 51-51, ISIP 891 FFP 51-51 FSIP 877	3832	3861		

USE ADDITIONAL SHEETS, IF NECESSARY, TO COMPLETE WELL RECORD.

**A F F I D A V I T**

STATE OF Colorado, COUNTY OF Jefferson SS,

Robert M. Richardson OF LAWFUL AGE, BEING FIRST DULY SWORN UPON HIS OATH, DEPOSES AND SAYS:

THAT HE IS Engineering Manager FOR Industrial Gas Services, Inc.  
 OPERATOR OF THE Toll LEASE, AND IS DULY AUTHORIZED TO MAKE THIS  
 AFFIDAVIT FOR AND ON BEHALF OF SAID OPERATOR, THAT WELL NO. 1-8 ON SAID LEASE HAS  
 BEEN COMPLETED AS OF THE 25th DAY OF May 19 82, AND THAT ALL  
 INFORMATION ENTERED HEREIN WITH RESPECT TO SAID WELL IS TRUE AND CORRECT.

FURTHER AFFIANT SAITH NOT.

(S) Robert M. Richardson

SUBSCRIBED AND SWORN TO BEFORE ME THIS 28th DAY OF May 19 82

L. Dore Maclean  
 NOTARY PUBLIC  
 4501 Wadsworth Blvd  
 Wheat Ridge Co 80033

RECEIVED  
 MY COMMISSION EXPIRES Feb 2, 1986  
 DIVISION OF OIL AND GAS  
 STATE OF COLORADO