


15-065-30283-00-00

Give All Information Completely  
Make Required Affidavit  
Mail or Deliver Report to:  
Conservation Division  
State Corporation Commission  
211 No. Broadway  
Wichita, Kansas

WELL PLUGGING RECORD

NORTH

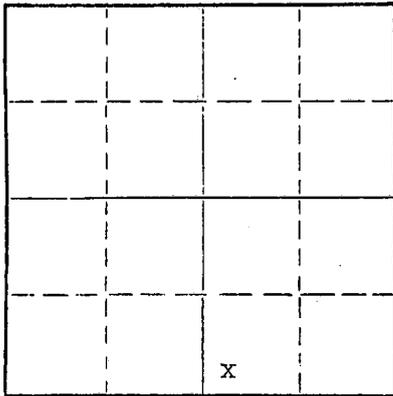

Locate well correctly on above  
Section Plat

Graham County. Sec. 19 Twp. 8 Rge. 25 ~~W~~ (W)  
Location as "NE/CNW%SW%" or footage from lines SW-SW-SE  
Lease Owner Jerry M. Helberg and Marion C. Helberg  
Lease Name Marion C. Helberg Well No. 2  
Office Address Morland, Kansas  
Character of Well (completed as Oil, Gas or Dry Hole) Dry Hole  
Date well completed June 16, 19 67  
Application for plugging filed June 26 19 67  
Application for plugging approved June 16 19 67  
Plugging commenced June 16 19 67  
Plugging completed June 16 19 67  
Reason for abandonment of well or producing formation lost slips in hole

If a producing well is abandoned, date of last production 19  
Was permission obtained from the Conservation Division or its agents before plugging was commenced? yes

Name of Conservation Agent who supervised plugging of this well W. L. Nichols  
Producing formation \_\_\_\_\_ Depth to top \_\_\_\_\_ Bottom \_\_\_\_\_ Total Depth of Well 1070 Feet  
Show depth and thickness of all water, oil and gas formations.

OIL, GAS OR WATER RECORDS

CASING RECORD

FORMATION	CONTENT	FROM	TO	SIZE	PUT IN	PULLED OUT
See drillers log						

Describe in detail the manner in which the well was plugged, indicating where the mud fluid was placed and the method or methods used in introducing it into the hole. If cement or other plugs were used, state the character of same and depth placed, from \_\_\_\_\_ feet to \_\_\_\_\_ feet for each plug set.

Set plug at 500 feet with 20 sacks of cement, set plug and bridge at 150 feet with 50 sacks of cement to bottom of cellar

RECEIVED  
STATE CORPORATION COMMISSION

JUL 12 1967

7-12-67

CONSERVATION DIVISION  
Wichita, Kansas

(If additional description is necessary, use BACK of this sheet)

Name of Plugging Contractor Company (Helberg Oil Company)  
Address Morland, Kansas

STATE OF Kansas, COUNTY OF Graham, ss.  
Jerry M. Helberg (employee of owner) (owner or operator) of the above-described well, being first duly sworn on oath, says: That I have knowledge of the facts, statements, and matters herein contained and the log of the above-described well as filed and that the same are true and correct. So help me God.

(Signature) Jerry M. Helberg  
Morland, Kansas (Address)

Subscribed and Sworn to before me this 7th day of July, 19 67

Richard J. Justice  
Notary Public.



15-065-30283-00-00 19-8-25W

DAILY DRILLING REPORT

DATE June 10-16 1967

COMPANY Helberg Oil Co. LEASE Helberg # 2 WELL NO. 2  
DISTRICT \_\_\_\_\_ DIVISION \_\_\_\_\_ RIG NO. \_\_\_\_\_

TOUR 12 A.M. TO 8 A.M.

TOUR 12 A.M. TO 8 A.M.			MEN AT WORK		HOURS	RATE
From	To	Formation (Indicate Drilling or Coring)	DRILLER			
			DERRICKMAN			
			FIREMAN			
			HELPER			
			HELPER			

HOURS RUN \_\_\_\_\_ HOURS LOST \_\_\_\_\_ CAUSE TIME LOST \_\_\_\_\_  
JOINTS DRILL PIPE IN HOLE \_\_\_\_\_ FEET KELLY IN HOLE \_\_\_\_\_ WEIGHT OF MUD \_\_\_\_\_  
CASING RECORD: SIZE \_\_\_\_\_ FEET \_\_\_\_\_ FORMATION \_\_\_\_\_ LINER \_\_\_\_\_ CEMENT \_\_\_\_\_  
BITS RUN \_\_\_\_\_ NO. ROUND TRIPS \_\_\_\_\_ SET NO. \_\_\_\_\_ CONE NO. \_\_\_\_\_

TOUR 8 A.M. TO 4 P.M.

TOUR 8 A.M. TO 4 P.M.			MEN AT WORK		HOURS	RATE
From	To	Formation (Indicate Drilling or Coring)	DRILLER			
0	1070	Sand, Shale, Shells	DERRICKMAN			
	T.D.		FIREMAN			
		Plugged hole (6-16-67)	HELPER			
		20 sacks cement at	HELPER	10'		
		50 sacks cement at		150'		

HOURS RUN \_\_\_\_\_ HOURS LOST \_\_\_\_\_ CAUSE TIME LOST \_\_\_\_\_  
JOINTS DRILL PIPE IN HOLE \_\_\_\_\_ FEET KELLY IN HOLE \_\_\_\_\_ WEIGHT OF MUD \_\_\_\_\_  
CASING RECORD: SIZE \_\_\_\_\_ FEET \_\_\_\_\_ FORMATION \_\_\_\_\_ LINER \_\_\_\_\_ CEMENT \_\_\_\_\_  
BITS RUN \_\_\_\_\_ NO. ROUND TRIPS \_\_\_\_\_ SET NO. \_\_\_\_\_ CONE NO. \_\_\_\_\_

TOUR 4 P.M. TO 12 P.M.

TOUR 4 P.M. TO 12 P.M.			MEN AT WORK		HOURS	RATE
From	To	Formation (Indicate Drilling or Coring)	DRILLER			
			DERRICKMAN			
			FIREMAN			
			HELPER			
			HELPER			

7-12-67  
**RECEIVED**  
STATE CORPORATION COMMISSION  
JUL 12 1967

HOURS RUN \_\_\_\_\_ HOURS LOST \_\_\_\_\_ CAUSE TIME LOST \_\_\_\_\_  
JOINTS DRILL PIPE IN HOLE \_\_\_\_\_ FEET KELLY IN HOLE \_\_\_\_\_ WEIGHT OF MUD \_\_\_\_\_  
CASING RECORD: SIZE \_\_\_\_\_ FEET \_\_\_\_\_ FORMATION \_\_\_\_\_ LINER \_\_\_\_\_ CEMENT \_\_\_\_\_  
BITS RUN \_\_\_\_\_ NO. ROUND TRIPS \_\_\_\_\_ SET NO. \_\_\_\_\_ CONE NO. \_\_\_\_\_

CONSERVATION DIVISION  
Wichita, Kansas

APPROVED \_\_\_\_\_