


STATE OF KANSAS
STATE CORPORATION COMMISSION

Give All Information Completely
Make Required Affidavit
Mail or Deliver Report to:
Conservation Division
State Corporation Commission
211 No. Broadway
Wichita, Kansas

15-665-00281-00-00
WELL PLUGGING RECORD

NORTH

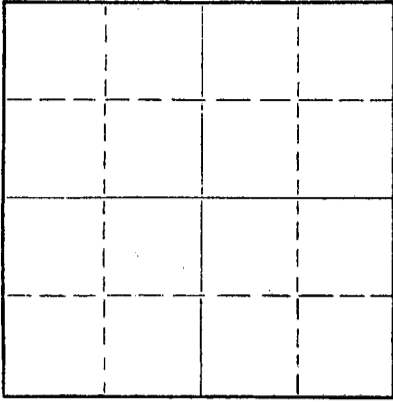

Locate well correctly on above
Section Plat

Graham County. Sec. 21 Twp. 8S Rge. (E) 25 (W)
Location as "NE/CNW/SW" or footage from lines NW NW SE
Lease Owner Tennessee Gas Transmission Company
Lease Name Adelia Schmied "A" Well No. 1
Office Address P.O. Box 163 - Great Bend, Kansas
Character of Well (completed as Oil, Gas or Dry Hole) Oil
Date well completed April 13 19 52
Application for plugging filed Oct. 9 19 57
Application for plugging approved Oct. 10 19 57
Plugging commenced Oct. 18 19 57
Plugging completed Oct. 24 19 57
Reason for abandonment of well or producing formation Failure to produce in commercial quantity.

If a producing well is abandoned, date of last production September 19 57
Was permission obtained from the Conservation Division or its agents before plugging was commenced? Yes

Name of Conservation Agent who supervised plugging of this well Eldon Petty
Producing formation Lansing Depth to top 3717 Bottom _____ Total Depth of Well 4470 Feet
Show depth and thickness of all water, oil and gas formations. 3902' PB

OIL, GAS OR WATER RECORDS

CASING RECORD

FORMATION	CONTENT	FROM	TO	SIZE	PUT IN	PULLED OUT
				8-5/8"OD	265'	None
				5-1/2"OD	3948'	1038'

Describe in detail the manner in which the well was plugged, indicating where the mud fluid was placed and the method or methods used in introducing it into the hole. If cement or other plugs were used, state the character of same and depth placed, from _____ feet to _____ feet for each plug set.

3902-3725' Filled with sand.
3725-3700' Five (5) sacks cement.
Surface hole squeezed with 40 sacks of mud @ 1,000 feet.
25 sacks cement @ 600'
15 sacks cement @ 265'
75'-30' mud
30'-to cellar 10 sacks cement.

RECEIVED
STATE CORPORATION COMMISSION
NOV 12 1957
11/12/57
CONSERVATION DIVISION
WICHITA, KANSAS

Name of Plugging Contractor R & S Pipe Pulling Company
Address Box 192 - Ellinwood, Kansas

STATE OF Kansas, COUNTY OF Rice, ss.
Glen E. Armour (employee of owner) of the above-described well, being first duly sworn on oath, says: That I have knowledge of the facts, statements, and matters herein contained and the log of the above-described well as filed and that the same are true and correct. So help me God.

(Signature) Glen E. Armour

(Address)

SUBSCRIBED AND SWORN TO before me this 11 day of November, 1957

My commission expires May 20, 1958

Notary Public.

PLUGGING
FILE SEC. 21 T. 8 R. 25
BOOK PAGE 52 LINE 16

WELL LOG BUREAU—KANSAS GEOLOGICAL SOCIETY
508 East Murdock, Wichita, Kansas


15-065-00281-00-00

Company. C.-U. BAY PETROLEUM
Farm. Schmied "A" No. 1

SEC. 21 T. 8 R. 25W
NW NW SE

Total Depth. 4474
Comm. 3-19-52 Comp. 5-6-52
Shot or Treated.
Contractor. Anschutz Drilling Co.
Issued. 7-12-52

County Graham
KANSAS

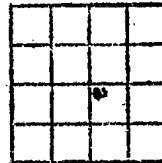

Elevation. 2384

Production. 68.18 bbls. /
5% wtr.

Figures Indicate Bottom of Formations.

surface clay	180
shale	985
sand & shale	1335
shale & shells	1600
shale	1365
red rock	2080
red rock & shale	2135
anhyd.	2180
shale	2225
shale & shells	2830
lime & shale	3728
lime	3926
lime & shale	4237
cherty lime	4258
Miss. chat	4273 $\frac{1}{2}$
Miss. lime	4290
lime	4354
dolo.	4470 RTD
dolo.	4474
Total Depth	

OCT 10 1957

REGISTRATION DIVISION
Wichita, Kansas

10/10/57

Tops:	
Topoka	3452
Heebner	3675
Lansing	3717
Congl.	4233
Miss. chert	4249
Miss. lime	4285
Viola	4326
Arbuckle	4400

D.S.T. 3733-51 open 1 hr. Rec. 215' oil /
220' muddy oil in 15" BHP 900 # F.P. 120#.
D.S.T. 3781-98 open 1 hr. Rec. 2035 SOCW
BHP 1330# F.P. 895#.
D.S.T. 3829-43 open 1 hr. Rec. 15'
oil & HOCM 1150# BHP D.S.T. 3874-93
open 1 hr. Rec. 450' gas 30' free oil.
60' SMC oil. 1300# BHP 720# F.P.
Perf. 12 / 3878-81 - 34 to 36 GOPH/9 hr.
1000 acid Max 425#. 12 BO/4 hrs. Plug 3870
Perf. 3838-44 swab 10 to 12 BPH/2 hrs.
Plug lose @ 3870. Set another plug @ 3810.
24 / 3740-44 200' OIH / SW. 500 acid
Swab 47 BO/4 hrs.
3-6-52 68.18 BO / 5% wtr. State Test.

PLUGGING
FILE SEC. 21 T. 8 R. 25W
BOOK PAGE 52 LINE 161