

15-065-01349-00-00

STATE OF KANSAS
STATE CORPORATION COMMISSION

Form CP-4

WELL PLUGGING RECORD

Give All Information Completely
Make Required Affidavit
Mail or Deliver Report to:
Conservation Division
State Corporation Commission
212 No. Market
Wichita, Kansas

Graham County, Sec 21 Twp 8 Rge. 25 (E) (W)

Location as "NE/CNW/SW" or footage from lines C N/2 N/2 NW/4

Lease Owner Ivy Oil Company

Lease Name Adelia Schmied Well No. 20

Office Address Plainville, Kansas

Character of Well (completed as Oil, Gas or Dry Hole)

Date well completed 19

Application for plugging filed 19

Application for plugging approved 19


Plugging commenced 10/28/68 19

Plugging completed 11/6/68 19

Reason for abandonment of well or producing formation depleted.

If a producing well is abandoned, date of last production 19

Was permission obtained from the Conservation Division or its agents before plugging was commenced? yes

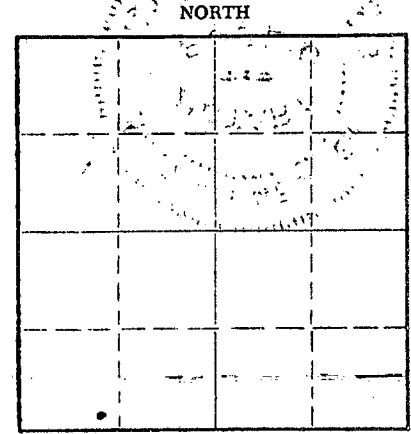

Locate well correctly on above Section Plat

Name of Conservation Agent who supervised plugging of this well Nichols

Producing formation Depth to top Bottom Total Depth of Well 3865 Feet

Show depth and thickness of all water, oil and gas formations.

OIL, GAS OR WATER RECORDS

CASING RECORD

| FORMATION | CONTENT | FROM | TO | SIZE | PUT IN | PULLED OUT |
|-----------|---------|------|----|--------|--------|------------|
| | | | | 8-5/8 | 250' | none |
| | | | | 5 1/2" | 3864' | 937' |
| | | | | | | |
| | | | | | | |
| | | | | | | |
| | | | | | | |
| | | | | | | |

Describe in detail the manner in which the well was plugged, indicating where the mud fluid was placed and the method or methods used in introducing it into the hole. If cement or other plugs were used, state the character of same and depth placed, from feet to feet for each plug set.

Ran sand to 3750' and ran 5 sacks of cement. Shot pipe at 2995', 1413', 947', worked pipe loose and pulled 30 joints. Plugged well with 55 bbls. of good drilling mud and 130 sacks of cement.

PLUGGING COMPLETE.

RECEIVED
STATE CORPORATION COMMISSION
NOV 18 1968
CONSERVATION DIVISION
Wichita, Kansas

11/15/68

(If additional description is necessary, use BACK of this sheet)

Name of Plugging Contractor KNIGHT CASING PULLING CO., INC.
Address CHASE, KANSAS

STATE OF KANSAS COUNTY OF RICE, ss.
NOEL J. KNIGHT


(employee of owner) or (owner or operator) of the above-described well, being first sworn on oath, says: That I have knowledge of the facts, statements, and matters herein contained and the log of the above-described well as filed and that the same are true and correct. So help me God.

(Signature) Noel Knight

CHASE, KANSAS

(Address)

Subscribed and sworn to before me this 15th day of November, 1968

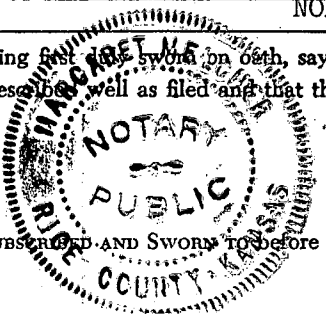

Margaret Melcher
Notary Public.

My commission expires Feb. 15, 1971