


15-065-02257-00-00

STATE OF KANSAS
STATE CORPORATION COMMISSION
Give All Information Completely
Make Required Affidavit
Mail or Deliver Report to:
Conservation Division
State Corporation Commission
800 Bitting Building
Wichita, Kansas

WELL PLUGGING RECORD

NORTH

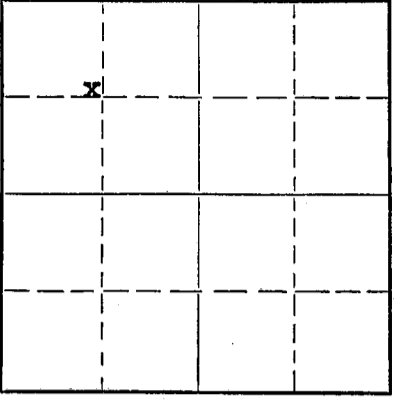

Locate well correctly on above Section Plat

Graham County, Sec. 21 Twp. 8S. Rge. 25 (E) W. (W)
Location as "NE/CNW 1/4 SW 1/4" or footage from lines
Lease Owner C. H. Bay
Lease Name Schmied "C" Well No. 4
Office Address Box 513 Chase, Kansas
Character of Well (completed as Oil, Gas or Dry Hole) dry hole
Date well completed October 19 1954
Application for plugging filed October 19 1954
Application for plugging approved October 19 1954
Plugging commenced October 19 1954
Plugging completed October 19 1954
Reason for abandonment of well or producing formation dry hole

If a producing well is abandoned, date of last production _____ 19____
Was permission obtained from the Conservation Division or its agents before plugging was commenced? Yes

Name of Conservation Agent who supervised plugging of this well Eldon Petty
Producing formation _____ Depth to top _____ Bottom _____ Total Depth of Well 3910 Feet
Show depth and thickness of all water, oil and gas formations.

OIL, GAS OR WATER RECORDS

CASING RECORD

Formation	Content	From	To	Size	Put In	Pulled Out
Surface Casing		0-	218.21'	8 5/8"	218.21'	None


Describe in detail the manner in which the well was plugged, indicating where the mud fluid was placed and the method or methods used in introducing it into the hole. If cement or other plugs were used, state the character of same and depth placed, from _____ feet to _____ feet for each plug set.

Filled with heavy mud to 200'
Set plug at 200' and cemented with 15 sacks cement through drill pipe
Filled with heavy mud to 40'.
Set plug at 40'.
Cemented to bottom of cellar with 10 sacks cement.

Handwritten: RCD 10/28/54
Stamp: STATE OF KANSAS
Stamp: UG
Stamp: SURVEYOR

(If additional description is necessary, use BACK of this sheet)
Name of Plugging Contractor A. L. Jackson Drilling Company
Address Box 194 Great Bend, Kansas

STATE OF Kansas, COUNTY OF Barton, ss.
A. L. Jackson, drilling contractor on (employer of owner or owner or operator) of the above-described well, being first-duly sworn on oath, says: That I have knowledge of the facts, statements, and matters herein contained and the log of the above-described well as filed and that the same are true and correct. So help me God.

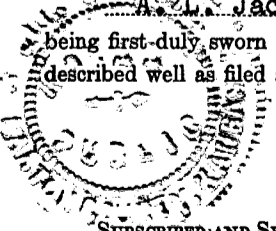

(Signature) A. L. Jackson
Box 194, Great Bend, Kansas
(Address)

SUBSCRIBED AND SWORN TO before me this 22 day of October, 1954.

Handwritten: Nick D. Carus

My commission expires May 9, 1955 Notary Public.

23-8390-s 6-51-20M

PLUGGING
FILE SEC 21 T 8 R 25W
BOOK PAGE 72 LINE 9

WELL LOG

Schmied "C" # 4
Graham County, Kansas

0 - 218	Surface soil-shale-sand
218 - 1015	Shale
1015 - 1075	Shale, Shells
1075 - 1370	Shale, Shells
1370 - 1420	Lime, Shale
1420 - 1640	Shale, Shells
1640 - 1650	Red Bed
1650 - 1860	Shale
1860 - 2100	Shale, Shells
2100 - 2135	Anhydrite
2135 - 2820	Shale, Shells
2820 - 2885	Lime
2885 - 2980	Shale, Shells
2980 - 3010	Shale, Lime
3010 - 3050	Lime, Shale Streaks
3050 - 3150	Lime, Shale Breaks
3150 - 3207	Lime
3207 - 3310	Shale, Lime Streaks
3310 - 3455	Shale, Lime Streaks
3455 - 3655	Shale, Lime
3655 - 3680	Lime, Shale
3680 - 3715	Lime
3715 - 3770	Shale, Lime
3770 - 3825	Lime
3825 - 3880	Lime, Shale
3880 - 3910 T D	Lime

STATE OF KANSAS
COUNTY OF BARTON ss

A. L. Jackson, owner of A. L. Jackson Drilling Co.,
being first duly sworn on oath, says: That I have knowledge of
the facts, statements, and matters herein contained and the
log of the above described well as filed and that the same are
true and correct.

A. L. Jackson
A. L. Jackson
Box 194
Great Bend, Kansas

Subscribed and sworn to before me this 22nd day of October, 1954.

Will D. Evans
Notary Public

My commission expires May 9, 1955.



PLUGGING
FILE SEC 21 T 8 R 25W
BOOK PAGE 72 LINE 9