


15-069-00499-00-00

Give All Information Completely
Make Required Affidavit
Mail or Deliver Report to:
Conservation Division
State Corporation Commission
211 No. Broadway
Wichita, Kansas

WELL PLUGGING RECORD

NORTH

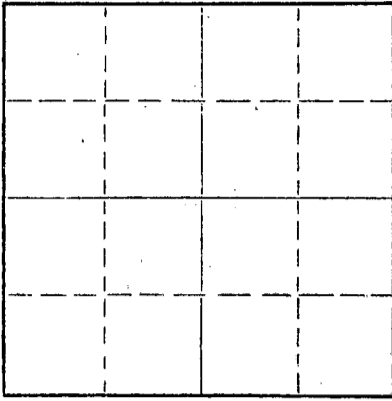

Locate well correctly on above
Section Plat

Graham County. Sec. 23 Twp. 8S Rge. 25W (E) (W)
Location as "NE/CNW/SW" or footage from lines C NE NW
Lease Owner Imperial Oil of Kansas, Inc.
Lease Name Minium "B" Well No. 1
Office Address 780 Fourth National Bldg., Wichita 2, Kansas
Character of Well (completed as Oil, Gas or Dry Hole) Dry Hole
Date well completed September 6, 19 58
Application for plugging filed September 6, 19 58
Application for plugging approved September 6, 19 58
Plugging commenced September 6, 19 58
Plugging completed September 6, 19 58
Reason for abandonment of well or producing formation No commercial quantities of oil found.
If a producing well is abandoned, date of last production _____ 19____
Was permission obtained from the Conservation Division or its agents before plugging was commenced? Yes.

Name of Conservation Agent who supervised plugging of this well A. D. Fabricius, Hill City, Kansas
Producing formation _____ Depth to top _____ Bottom _____ Total Depth of Well 3908 Feet
Show depth and thickness of all water, oil and gas formations.

OIL, GAS OR WATER RECORDS

CASING RECORD

FORMATION	CONTENT	FROM	TO	SIZE	PUT IN	PULLED OUT
				8-5/8"	8-29-58	

Describe in detail the manner in which the well was plugged, indicating where the mud fluid was placed and the method or methods used in introducing it into the hole. If cement or other plugs were used, state the character of same and depth placed, from _____ feet to _____ feet for each plug set.

Set No. 1 Plug at 550' with 25 sacks cement. Set No. 2 Plug at 205' with 15 sacks cement. Set No. 3 Plug at 40' with 10 sacks cement.

(If additional description is necessary, use BACK of this sheet)

Name of Plugging Contractor Imperial Oil of Kansas, Inc.
Address 780 Fourth National Bldg., Wichita 2, Kansas

STATE OF KANSAS, COUNTY OF SEDGWICK, ss.
Raymond L. Bacon (employee of ~~owner~~ or ~~owner's representative~~) of the above-described well, being first duly sworn on oath, says: That I have knowledge of the facts, statements, and matters herein contained and the log of the above-described well as filed and that the same are true and correct. So help me God. IMPERIAL OIL OF KANSAS, INC.
(Signature) By: Raymond L. Bacon V-P.
780 Fourth National Bldg., Wichita 2, Kansas
(Address)



Mona L. Latier
Mona L. Latier Notary Public.

PLUGGING
FILE SEC 23 T. 8 R. 25W
BOOK PAGE 130 LINE 8

SEP 23 1958
9-23-58
CONSERVATION DIVISION
Wichita, Kansas

DRILLER'S LOG

15-065-00499-00-00

Imperial Oil of Kansas, Inc.
780 Fourth National Building
Wichita 2, Kansas

Minium "B" No. 1
C NE NW Sec. 23-8S-25W
Graham County, Kansas

Total Depth: 3908'

Elevation: 2352' R.B.
Production: D & A

Commenced: 8-29-58 Completed: 9-6-58

Contractor: Imperial Oil of Kansas, Inc.
Wichita 2, Kansas

Casing Record: Set 8-5/8" Surface Pipe at 210' with 150 sacks cement.

Figures indicate bottom of formations:

		<u>TOPS</u>	
Sand & Shale	212'		
Shale & Shells	800'	Anhydrite	2084' (/ 268)
Shale - Shells & Sand	2084'	Heebner	3636' (-1284)
Anhydrite	2117'	Toronto	3658' (-1306)
Shale	2125'	Lansing	3675' (-1323)
Shale & Shells	2530'	Rotary Total Depth	3908' (-1556)
Shale & Lime	2790'		
Lime (Ft. Riley)	2850'		
Shale & Lime	3640'		
Lime	3805'		
Shale & Lime	3830'		
Lime	3908'		
Total Depth	3908'		

We hereby certify this to be a correct and accurate log of the above described well as shown on the daily drilling reports.

IMPERIAL OIL OF KANSAS, INC.

By: Ray L. Bandy
Vice-President



Subscribed and sworn to before me this 15th day of September, 1958

My Commission Expires:
July 7, 1962

PLUGGING
FILE SEC 23 T8 R25W
BOOK PAGE 130 LINE 8

RECEIVED
STATE CORPORATION COMMISSION
9-23-58
SEP 23 1958
Mona L. Sater
Notary Public