

Give All Information Completely  
Make Required Affidavit  
Mail or Deliver Report to:  
Conservation Division  
State Corporation Commission  
800 Bittling Building  
Wichita, Kansas

19-065-00211-00-00

WELL PLUGGING RECORD

Graham County. Sec. 24 Twp. 8 Rge. 25 (E) (W)

Location as "NE/CNW $\frac{1}{4}$ SW $\frac{1}{4}$ " or footage from lines SW SW SE

Lease Owner I. W. Siegel

Lease Name Engleman Well No. 1

Office Address 12 N. Gate Road, Colorado Springs, Colorado

Character of Well (completed as Oil, Gas or Dry Hole) Dry Hole

Date well completed April 18, 19 52

Application for plugging filed April 18, 19 52

Application for plugging approved April 18, 19 52


Plugging commenced April 18, 19 52

Plugging completed April 18, 19 52

Reason for abandonment of well or producing formation Dry Hole

If a producing well is abandoned, date of last production 19

Was permission obtained from the Conservation Division or its agents before plugging was commenced? Yes

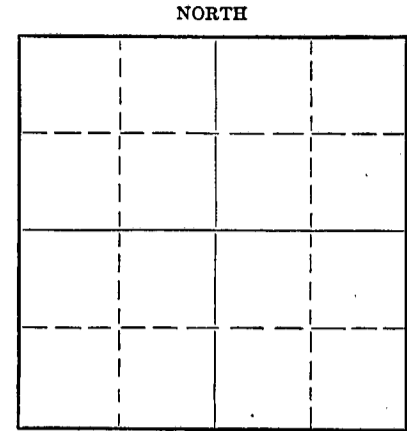

Locate well correctly on above Section Plat

Name of Conservation Agent who supervised plugging of this well State Pluggger Petty - Hays, Kansas

Producing formation Depth to top Bottom Total Depth of Well 4250 Feet

Show depth and thickness of all water, oil and gas formations.

OIL, GAS OR WATER RECORDS

CASING RECORD

Table with 7 columns: Formation, Content, From, To, Size, Put In, Pulled Out. Row 1: From 0' to 228', Size 8 5/8", Put In 228', Pulled Out None.

Describe in detail the manner in which the well was plugged, indicating where the mud fluid was placed and the method or methods used in introducing it into the hole. If cement or other plugs were used, state the character of same and depth placed, from feet to feet for each plug set.

From 4250' to 211 1/2' - Heavy Rotary Mud  
From 211 1/2' to 210' - Wooden Plug  
From 210' to 164' - 15 Sacks Cement  
From 164' to 41 1/2' - Heavy Rotary Mud  
From 41 1/2' to 40' - Wooden Plug  
From 40' to 6' - 6 Sacks Cement, 1/2 Sack Hull  
From 6' to Surface to Cellar

Name of Plugging Contractor Peel Brothers, Inc. Address P.O. Box 88, Hoisington, Kansas

RECEIVED STATE CORPORATION COMMISSION JUL 28 1952

STATE OF KANSAS COUNTY OF BARTON PEEL BROTHERS, INC. (employee of owner) or (owner or operator) of the above-described well, Wichita, Kansas

being first duly sworn on oath, says: That I have knowledge of the facts, statements, and matters herein contained and the log of the above-described well as filed and that the same are true and correct. So help me God. PEEL BROTHERS, INC.

(Signature) BY: [Signature] P.O. Box 88, Hoisington, Kansas (Address)

SUBSCRIBED AND SWORN to before me this 18th day of April, 19 52

My commission expires April 23, 1955 [Signature] Notary Public.

PLUGGING FILE SEC 24 T 8 R 25 SOOK PAGE 10 LINE 28

DRILLER'S

LOG

15-065-00211-00-00

Company: I. W. Siegel SW SW SE  
 Farm: Engleman Well No. 1 Sec. 24, Twp. 8, Rge. 25,  
 Comm: 4-5-52 Comp: 4-18-52 County: Graham,  
 Kansas.  
 Total Depth: 4250' Elevation:  
 Contractor: Peel Brothers, Inc. Production: Dry  
 Casing: 8 5/8" @ 228' cem.

Figures below indicate bottom of formations

Clay and Sand	25
Shale and Post Rock	230
Shale and Shells	900
Pyrite	960
Shale and Sand	1845
Shale and Red Rock	2060
Anhydrite	2090
Shale and Shells	2650
Lime and Shale	2800
Shale and Shells	2975
Lime and Shale	3150
Shale, Lime and Shells	3215
Lime and Shale	3315
Shale and Shells	3415
Shale and Lime Shells	3515
Shale and Lime	3565
Lime	3910
Lime and Shale	4185
Lime and Chert	4220
Shale and Lime	4250
Total Depth	4250

This is to certify that the above information is to the best of my knowledge true and correct.

THE CORPORATION COMMISSION  
 JUL 28 1952  
 CONSERVATION DIVISION  
 Wichita, Kansas  
 7-28-52

PEEL BROTHERS, INC.,

BY:

*Mendell E. Peel*

SUBSCRIBED AND SWORN to before me this 18th day of April, 1952.



My commission expires April 23, 1955.

*Bernice L. Jewin*  
 Notary Public - Barton County, Ks.

**PLUGGING**  
 FILE SEC 24 T 8 R 45  
 BOOK PAGE 10 LINE 28