

15-065-00211-00-01

STATE OF KANSAS
STATE CORPORATION COMMISSION


WELL PLUGGING RECORD

Give All Information Completely
Make Required Affidavit
Mail or Deliver Report to:
Conservation Division
State Corporation Commission
211 No. Broadway
Wichita, Kansas

Graham County, Sec. 24 Twp. 8 Rge. 25 (E) W (W)

Location as "NE/CNW/SW" or footage from lines. SW SW SE
Lease Owner Jones, Shelbrune & Farmer, Inc.
Lease Name Engleman #2 Well No. _____
Office Address Russell, Kansas
Character of Well (completed as Oil, Gas or Dry Hole) _____
Date well completed _____ 19____
Application for plugging filed _____ 19____
Application for plugging approved _____ 19____
Plugging commenced 11-21-57 19____
Plugging completed 11-27-57 19____
Reason for abandonment of well or producing formation _____

NORTH

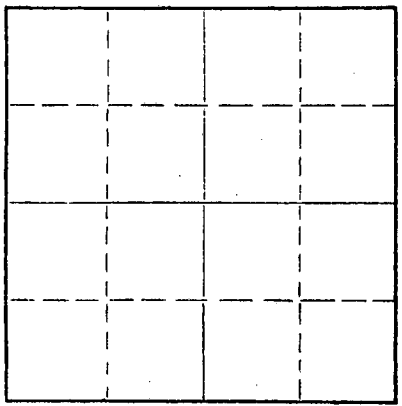

Locate well correctly on above
Section Plat

If a producing well is abandoned, date of last production _____ 19____
Was permission obtained from the Conservation Division or its agents before plugging was commenced? yes

Name of Conservation Agent who supervised plugging of this well Eldon Petty
Producing formation _____ Depth to top _____ Bottom _____ Total Depth of Well 4250 Feet
Show depth and thickness of all water, oil and gas formations.

OIL, GAS OR WATER RECORDS

CASING RECORD

FORMATION	CONTENT	FROM	TO	SIZE	PUT IN	PULLED OUT
				8-5/8"	203'	none
				5-1/2"	3930'	1253'

Describe in detail the manner in which the well was plugged, indicating where the mud fluid was placed and the method or methods used in introducing it into the hole. If cement or other plugs were used, state the character of same and depth placed, from _____ feet to _____ feet for each plug set.

Checked the hole and found it open. Filled with sand to 3710' and ran 5 sacks of cement. Pulled 5 1/2" casing to 700' and pumped in 20 sacks of mud and 20 sacks of cement. Pulled casing to 200' and pumped in 20 sacks of cement. Pulled casing out of hole, bailed hole down and mudded and ran 5 sacks of cement to base of dollar.

RECEIVED
STATE CORPORATION COMMISSION
DEC 6 1957
CONSERVATION DIVISION
Wichita, Kansas


Name of Plugging Contractor West Supply Co., Inc.
Address Chase, Kansas

STATE OF KANSAS COUNTY OF RICE, ss.

(employee of owner) or (owner or operator) of the above-described well, being first duly sworn on oath, says: That I have knowledge of the facts, statements, and matters herein contained and the log of the above-described well as filed and that the same are true and correct. So help me God.

(Signature) John W. Farmer
(Address) _____

SUBSCRIBED AND SWORN to before me this 29th day of November, 19 57
My commission expires 9-27-58
Thomas V. Hyslop
Notary Public.

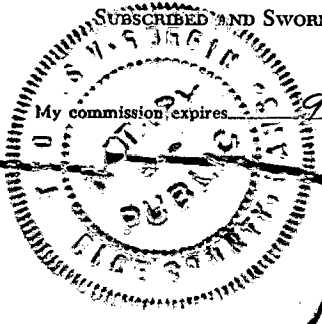

PLUGGING
FILE SEC 24 T 8 R 25W
BOOK PAGE 6 / LINE 2