

AFFIDAVIT AND COMPLETION FORM

ACO-1

This form must be filed in triplicate with the Kansas Corporation Commission, 200 Colorado Derby Building, Wichita, Kansas 67202, within five days after the completion of the well, regardless of how the well was completed. Circle one: ~~XXX~~, ~~gas~~, dry, ~~SWD~~, ~~XXX~~, ~~XXXXXXXX~~ Please type. Complete ALL sections. Applications must be filed for dual completion, commingling, salt water disposal and injection. Attach wireline logs (i.e. electrical log, sonic log, gamma ray neutron log, etc.) KCC#-(316) 263-3238.


OPERATOR K & E Petroleum, Inc.
 ADDRESS 300 Hardage Center, 100 S. Main
Wichita, KS 67202
 **CONTACT PERSON Wayne L. Brinegar
 PHONE: 316-264-4301

API NO. 15-065-21,519 ~~00-00~~
 COUNTY Graham
 FIELD Wildcat
 LEASE Jones

PURCHASER _____
 ADDRESS _____

WELL NO. 1
 WELL LOCATION App. C N/2 SE SW NW
520 Ft. from South Line and
1010 Ft. from West Line of
 the NW/4 SEC. 10 TWP. 8S RGE. 23W

DRILLING CONTRACTOR Abercrombie Drilling, Inc.
 ADDRESS 801 Union Center
Wichita, KS 67202

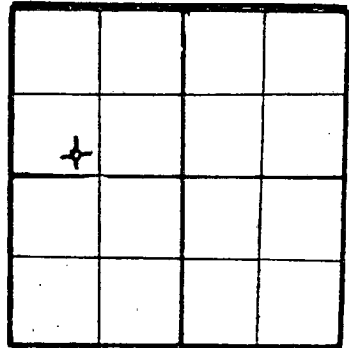

WELL PLAT
~~(XXXXXX)~~
 or (Full)
 Section -
 Please
 indicate.

PLUGGING CONTRACTOR Abercrombie Drilling, Inc.
 ADDRESS 801 Union Center, Wichita, KS 67202
 TOTAL DEPTH 3755' PBTD _____
 SPUD DATE 10/26/81 DATE COMPLETED 10/30/81
 ELEV: GR 2226' DF _____ KB 2231'

KCC _____
 KGS _____

DRILLED WITH ~~(CABLE)~~ (ROTARY) ~~(AIR)~~ TOOLS
 Report of all strings set — surface, intermediate, production, etc.: (New)/(~~XXX~~) casing. ~~PLUG~~

Purpose of string	Size hole drilled	Size casing set (in O.D.)	Weight lbs/ft.	Setting depth	Type cement	Sacks	Type and percent additives
Surface	12 1/4"	8 5/8"	20#	324.59'	common	225	2% gel 3% C.C.

LINER RECORD			PERFORATION RECORD		
Top, ft.	Bottom, ft.	Sacks cement	Shots per ft.	Size & type	Depth interval

TUBING RECORD		ACID, FRACTURE, SHOT, CEMENT SQUEEZE RECORD	
Size	Setting depth	Packer set at	Amount and kind of material used

RECEIVED
 STATE CORPORATION COMMISSION
 NOV 16 1981
 CONSERVATION DIVISION
 Wichita, Kansas
 11-16-81

TEST DATE:		PRODUCTION			
Date of first production	Producing method (flowing, pumping, gas lift, etc.)	A.P.I. Gravity		Gas-oil ratio	
RATE OF PRODUCTION PER 24 HOURS	OH	Gas	Water	Gas-oil ratio	
Disposition of gas (vented, used on lease or sold)			Producing interval(s)		

** The person who can be reached by phone regarding any questions concerning this information.
 A witnessed initial test by the Commission is required if the well produces more than 25 BOPD or is located in a Basic Order Pool.

Name of lowest fresh water producing stratum Unknown Depth 1025'
 Estimated height of cement behind pipe at surface

WELL LOG

Show all important zones of porosity and contents thereof; cored intervals, and all drill-stem tests, including depth interval tested, cushion used, time tool open, flowing and shut-in pressures, and recoveries.

SHOW GEOLOGICAL MARKERS, LOGS RUN, OR OTHER DESCRIPTIVE INFORMATION.

FORMATION DESCRIPTION, CONTENTS, ETC.	TOP	BOTTOM	NAME	DEPTH
Clay, Sand & Shale	0	328	SAMPLE TOPS	
Shale & Sand	328	650		
Sand & Shale	650	1888	Anhydrite	1888'
Anhydrite	1888	1925	B/Anhydrite	1925'
Sand & Shale	1925	2310	Topeka	3265'
Shale	2310	2829	Heebner	3473'
Shale & Lime	2829	3614	Toronto	3500'
Lime	3614	3755	Lansing/KC	3517'
Rotary Total Depth		3755	B/KC	3724'
			R.T.D.	3755'

USE ADDITIONAL SHEETS, IF NECESSARY, TO COMPLETE WELL RECORD.

A F F I D A V I T

STATE OF KANSAS, COUNTY OF SEDGWICK SS,

Wayne L. Brinegar OF LAWFUL AGE, BEING FIRST DULY SWORN UPON HIS OATH, DEPOSES AND SAYS:

THAT HE IS Executive Vice President FOR K & E Petroleum, Inc.
 OPERATOR OF THE Jones LEASE, AND IS DULY AUTHORIZED TO MAKE THIS
 AFFIDAVIT FOR AND ON BEHALF OF SAID OPERATOR, THAT WELL NO. 1 ON SAID LEASE HAS
 BEEN COMPLETED AS OF THE 30th DAY OF October 1981, AND THAT ALL
 INFORMATION ENTERED HEREIN WITH RESPECT TO SAID WELL IS TRUE AND CORRECT.

FURTHER AFFIANT SAITH NOT.

(S) Wayne L. Brinegar
 SUBSCRIBED AND SWORN TO BEFORE ME THIS 11th DAY OF November 1981



Betty J. Weltz
 NOTARY PUBLIC
 Betty J. Weltz

MY COMMISSION EXPIRES: September 6, 1983