


15-065-01926-00-00

Give All Information Completely  
Make Required Affidavit  
Mail or Deliver Report to:  
Conservation Division  
State Corporation Commission  
212 No. Market  
Wichita, Kansas

WELL PLUGGING RECORD

Graham County, Sec. 11 Twp. 9 Rge. 21 (E) W

Location as "NE/CNW/SW" or footage from lines N 1/2 SW SW  
Lease Owner Sun Oil Company  
Lease Name E. Davignon Well No. 3  
Office Address 1720 S. Bellaire, Suite 300 Denver, CO 80222  
Character of Well (completed as Oil, Gas or Dry Hole) Oil  
Date well completed 11-4 19 74  
Application for plugging filed 10-21 19 74  
Application for plugging approved 10-23 19 74  
Plugging commenced 12-5 19 74  
Plugging completed 12-7 19 74  
Reason for abandonment of well or producing formation State Regulations  
Require Plugging  
If a producing well is abandoned; date of last production 19  
Was permission obtained from the Conservation Division or its agents before plugging was commenced? Yes

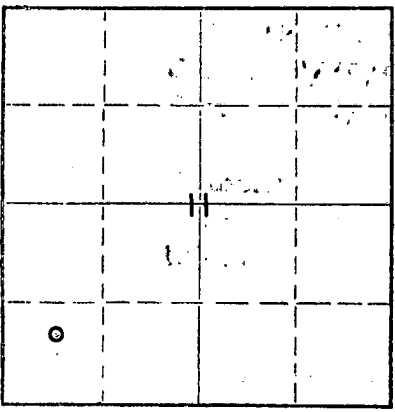

Locate well correctly on above Section Plat

Name of Conservation Agent who supervised plugging of this well W. L. Nichols  
Producing formation Arhuckle Line Depth to top 3749 Bottom 3758 Total Depth of Well 3758 Feet  
Show depth and thickness of all water, oil and gas formations.

OIL, GAS OR WATER RECORDS

CASING RECORD

FORMATION	CONTENT	FROM	TO	SIZE	PUT IN	PULLED OUT
		0	290	10 3/4	290	0
		0	3749	5 1/2	3749	765

Describe in detail the manner in which the well was plugged, indicating where the mud fluid was placed and the method or methods used in introducing it into the hole. If cement or other plugs were used, state the character of same and depth placed, from feet to feet for each plug set.  
Dumped 30 feet of sand from 3740 to 3710 and 4 sacks of cement at 3710. Shot off 5 1/2" casing at 765'. Displaced hole with 25 sacks of gel, 3 sacks of hulls 80 sacks of cement, 15 sacks of gel. Released plug and dumped 60 sacks of cement to surface

RECEIVED  
STATE CORPORATION COMMISSION  
DEC 23 1974  
CONSERVATION DIVISION  
WICHITA, KANSAS

Name of Plugging Contractor Charles Crowe Drilling Co. 12-23-74  
Address Box 706, Hays, Kansas

STATE OF Colorado COUNTY OF Denver, ss.  
D. A. Coppedge (employee of owner) or (owner or operator) of the above-described well, being first duly sworn on oath, says: That I have knowledge of the facts, statements, and matters herein contained and the log of the above-described well as filed and that the same are true and correct. So help me God.

(Signature) D. A. Coppedge  
1720 S. Bellaire, Suite 300, Denver, CO 80222 (Address)

SUBSCRIBED AND SWORN to before me this 19th day of December, 1974  
Mary Marson

