


Give All Information Completely
Make Required Affidavit
Mail or Deliver Report to:
Conservation Division
State Corporation Commission
211 No. Broadway
Wichita, Kansas

WELL PLUGGING RECORD

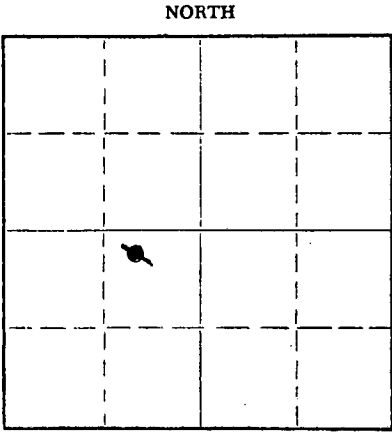

Locate well correctly on above Section Plat

Graham County, Sec. 21 Twp. 9 Rge. 21 (X) W (W)

Location as "NE/CNW/SW" or footage from lines NW 1/4 NE 1/4 SW 1/4

Lease Owner C-G Drilling Co

Lease Name Benson Well No. 1

Office Address 107 Rule Building oil

Character of Well (completed as Oil, Gas or Dry Hole) Abandoned/well

Date well completed ~~Nov 26~~ April 26 19 62 50

Application for plugging filed Nov. 26 19 62

Application for plugging approved Nov. 26 19 62

Plugging commenced Nov. 26 19 62

Plugging completed Nov. 26 19 62

Reason for abandonment of well or producing formation No longer commercial

If a producing well is abandoned, date of last production Feb 28 19 62

Was permission obtained from the Conservation Division or its agents before plugging was commenced? yes

Name of Conservation Agent who supervised plugging of this well Eldon Petty

Producing formation Arbuckle Depth to top 3777 Bottom 3786 Total Depth of Well 3786 Feet

Show depth and thickness of all water, oil and gas formations.

OIL, GAS OR WATER RECORDS

CASING RECORD

FORMATION	CONTENT	FROM	TO	SIZE	PUT IN	PULLED OUT
				8-5/8"	262.68	none
				5-1/2"	3780	none

Describe in detail the manner in which the well was plugged, indicating where the mud fluid was placed and the method or methods used in introducing it into the hole. If cement or other plugs were used, state the character of same and depth placed, from _____ feet to _____ feet for each plug set.

Filled hole with heavy mud to 560'. Filled to top with cement.

RECEIVED
STATE CORPORATION COMMISSION

JAN 2 1963

1-2-63
CONSERVATION DIVISION
Wichita, Kansas

(If additional description is necessary, use BACK of this sheet)
Name of Plugging Contractor Globe Cementing Co.
Address Great Bend, Kansas

STATE OF Kansas, COUNTY OF Sedgwick, ss.
G. F. Galloway (XXXXXXXXXX) or (owner or operator) of the above-described

well, being first duly sworn on oath, says: That I have knowledge of the facts, statements, and matters herein contained and the log of the above-described well as filed and that the same are true and correct. So help me God.

(Signature) G. F. Galloway
107 Rule Building

(Address)

SUBSCRIBED AND SWORN to before me this 3rd day of December, 19 62

My commission expires May 20, 1963

Vicky Jacobs
Notary Public.



15-065-01028-00-00
WELL LOG

OPERATOR C-G Drilling Co.
 WELL NAME Benson #1
 TOTAL DEPTH 3786'
 COMM. Apr 14, 1950 COMP. Nov 26, 1962
 RIG NO.
 CASING: 262.68' *8 jts of 8-5/8" OD Csg.
 3780' of 5-1/2" OD Csg (119 jts.)

SEC. 21-9-21W
 LOC. NW¼ NE¼ SW¼
 COUNTY Graham
 STATE Kansas
 ELEVATION 2268' D.F.
 PRODUCTION: Abandoned

All measurements taken from the top of rotary bushing.

FROM	TO	FORMATION	DEVIATION FROM VERTICAL	REMARKS:
0	260	shale-Sand		
260	760	Shale-Shells		
760	825	Shale-Shells		
825	920	Sand		
920	1125	Shale-Shells		
1125	1245	Shale-Sand		
1245	1470	Sand		
1470	1690	Sand-Shale		
1690	1735	Shale	1700' - 0°	
1735	1780	Anhydrite		
1780	1815	Iron-Shale		
1815	1979	Shale-Shells-Iron		
1970	2180	Shale	2100' - 0°	
2180	2255	Broken Lime		
2255	2555	Lime-Shale	2500' - 00°	
2555	2685	Shale-Lime		
2685	2870	Lime-Shale		
2870	3210	Shale-Lime	3000' - 0°	
3210	3442	Lime-Shale		
3442	3786	Lime		

RECEIVED
 STATE CORPORATION COMMISSION
 JAN 2 1963
 1-2-63
 CONSERVATION DIVISION
 Wichita, Kansas

STATE OF KANSAS)
) SS.
 COUNTY OF SEDGWICK)

The undersigned hereby certifies that to the best of his knowledge and belief, the above facts are true and correct.

C-G DRILLING CO.

By

G. F. Galloway

THIS 3rd day of December, 1962.

Vicky Jacobs
 Vicky Jacobs - Notary Public

