

15-065-01453-0000


STATE OF KANSAS
STATE CORPORATION COMMISSION

Form CP-4

WELL PLUGGING RECORD

Give All Information Completely
Make Required Affidavit
Mail or Deliver Report to:
Conservation Division
State Corporation Commission
P. O. Box 17027
Wichita, Kansas 67217
NORTH

Graham County, Sec. 21 Twp. 9 Rge. (E) 21 (W)
Location as "NE/CNW&SW" or footage from lines. NW SE NW
Lease Owner Barnett Oil, Inc.
Lease Name Anderson ^{NCC} ~~Anderson~~ "B" Well No. 2
Office Address 411 First National Bank Bldg., Wichita, Kansas
Character of Well (completed as Oil, Gas or Dry Hole) oil 67202
Date well completed Jan. 23 19 48
Application for plugging filed Aug. 27 19 74
Application for plugging approved 19
Plugging commenced Oct. 1 19 74
Plugging completed Oct. 15 19 74
Reason for abandonment of well or producing formation depleted

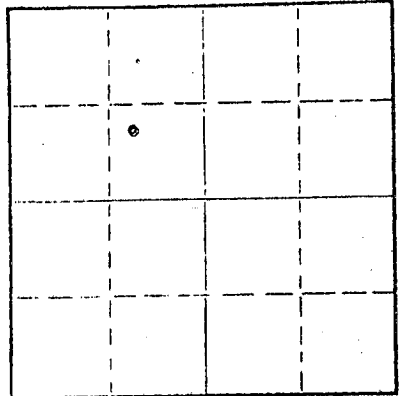

Locate well correctly on above
Section Plat

If a producing well is abandoned, date of last production 19
Was permission obtained from the Conservation Division or its agents before plugging was commenced? yes

Name of Conservation Agent who supervised plugging of this well W. L. Nichols
Producing formation _____ Depth to top _____ Bottom _____ Total Depth of Well 3789 Feet
Show depth and thickness of all water, oil and gas formations.

OIL, GAS OR WATER RECORDS

CASING RECORD

FORMATION	CONTENT	FROM	TO	SIZE	PUT IN	PULLED OUT
			150'	8 5/8"	150'	none
			3784'	5 1/2"	3784'	906.20

Describe in detail the manner in which the well was plugged, indicating where the mud fluid was placed and the method or methods used in introducing it into the hole. If cement or other plugs were used, state the character of same and depth placed, from _____ feet to _____ feet for each plug set.

Sanded back to 3770' and dumped 5 sacks of cement.
Allied Cementing Company plugged well pumping in 5 sacks of hulls, 25 sacks of gel and 150 cubic feet of cement.

RECEIVED
STATE CORPORATION COMMISSION
OCT 30 1974
CONSERVATION DIVISION
Wichita, Kansas
10-30-74

Name of Plugging Contractor PIPE PULLERS, INC.
Address Box 128, Ellinwood, Kansas 67526

STATE OF KANSAS, COUNTY OF BARTON, ss.
Evelyn Roth (employee of owner) or (owner or operator) of the above-described well, being first duly sworn on oath, says: That I have knowledge of the facts, statements, and matters herein contained and the log of the above-described well as filed and that the same are true and correct. So help me God.

(Signature) Evelyn Roth
Ellinwood, Kansas (Address)

SUBSCRIBED AND SWORN TO before me this 23 day of October, 19 74

My commission expires _____
JENNY KASSELMAN
NOTARY PUBLIC
BARTON COUNTY, KANSAS
MY COMM. EXP. JULY 16, 1978

Jenny Kasselmann
Notary Public.

WELL LOG BUREAU - KANSAS GEOLOGICAL SOCIETY
 508 E. Mardock,
 Wichita, Kansas

15-065-01493-00-00


COPY

Company - BARNETT & SHIELDS OIL CO.
 Farm - Anderson "B" No. 2
 Anderson ^{KU}_{ZAP}

SEC. 21 T. 9 R. 21W
 NW SE NW

Total Depth. 3789
 Comm. 1-8-48 Comp. 1-23-48
 Shot or Treated.
 Contractor.
 Issued. 7-7-51

County. Graham
 KANSAS

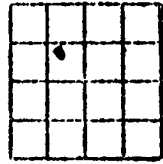

Elevation. 2260

Production. 2200 Bbls.

CASING:

8 5/8" 150' - 125 sks
 5 1/2" 3784' - 125 sks

Figures Indicate Bottom of Formations.

shale & shells	810
sand	990
shale & lime	1020
shale	1070
sand	1140
shale & shells	1720
anhyd.	1770
lime & shale	1950
shale & shells	2150
shale & lime	2425
lime	2515
lime & shale	2885
lime	2955
shale & lime	3260
lime	3390
lime & shale	3440
lime	3687
shale	3703
lime & shale	3735
shale	3784
lime	3789
Total Depth	

RECEIVED
 STATE CORPORATION COMMISSION
 AUG 28 1974
 CONSERVATION DIVISION
 Wichita, Kansas

8-28-74