

15-065-02917-00-00

WELL PLUGGING RECORD

Give All Information Completely
Make Required Affidavit
Mail or Deliver Report to:
Conservation Division
State Corporation Commission
211 No. Broadway
Wichita, Kansas

Graham County, Sec. 21 Twp. 9 Rge. 21W (E) (W)

Location as "NE/CNW/SW" or footage from lines NE NW SW

Lease Owner C-G Drilling Co.

Lease Name A.P. Benson Well No. 1

Office Address 107 Rule Building

Character of Well (completed as Oil, Gas or Dry Hole) Abandoned oil well

Date well completed June 30 19 50

Application for plugging filed November 26 19 62

Application for plugging approved November 26 19 62


Plugging commenced November 26 19 62

Plugging completed November 26 19 62

Reason for abandonment of well or producing formation No longer commercial

If a producing well is abandoned, date of last production August 19 57

Was permission obtained from the Conservation Division or its agents before plugging was commenced? Yes

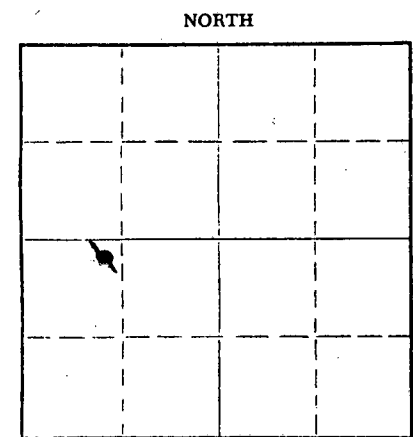

Locate well correctly on above Section Plat

Name of Conservation Agent who supervised plugging of this well Eldon Petty

Producing formation Arbuckle Depth to top 3819 Bottom 3824' Total Depth of Well 3824 Feet

Show depth and thickness of all water, oil and gas formations.

OIL, GAS OR WATER RECORDS

CASING RECORD

FORMATION	CONTENT	FROM	TO	SIZE	PUT IN	PULLED OUT
				10-3/4"	252'	None
				5-1/2"	3822'	None

Describe in detail the manner in which the well was plugged, indicating where the mud fluid was placed and the method or methods used in introducing it into the hole. If cement or other plugs were used, state the character of same and depth placed, from _____ feet to _____ feet for each plug set. --

Filled hole with heavy mud to 560'.
Filled to top with cement.

RECEIVED
STATE CORPORATION COMMISSION

JAN 4 1963

1-4-63

CONSERVATION DIVISION
Wichita, Kansas

(If additional description is necessary, use BACK of this sheet)

Name of Plugging Contractor Globe Cementing Co.

Address Great Bend, Kansas

STATE OF Kansas, COUNTY OF Sedgwick, ss. G.F. Galloway


(employee or owner) or (owner or operator) of the above-described well, being first duly sworn on oath, says: That I have knowledge of the facts, statements, and matters herein contained and the log of the above-described well as filed and that the same are true and correct. So help me God.

(Signature) G.F. Galloway
G.F. Galloway 107 Rule Bldg.
(Address)

SUBSCRIBED AND SWORN to before me this 3rd day of December, 19 62

My commission expires May 20, 1963

Vicky Jacobs
Vicky Jacobs Notary Public.

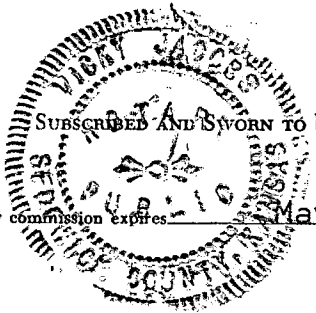

15-065-02917-00-00

WELL LOG

OPERATOR C-G Drilling Co. Oil Corporation. SEC. 21-9-21W
 WELL NAME ^{A.P. KCC} Benson #1 LOC. NE NW SW
 TOTAL DEPTH 3824' COUNTY Graham
 COMM. 6/19/50 COMP. 6/30/50 STATE Kansas
 RIG NO. ELEVATION 2296'
 CASING: 10-3/4" 252' com w/135 sacks PRODUCTION: Abandoned
 5-1/2" 3822' com. w/100 sacks 11/26/62

All measurements taken from the top of rotary bushing.

FROM	TO	FORMATION	DEVIATION FROM VERTICAL	REMARKS:
0	80	Surface Sand-Clay		
	710	Shale-Shells		
	1200	Sand-Shale		
	1430	Sand		
	1595	Shale		
	1750	Shale-Redbed		
	1788	Anhydrite		
	2250	Shale-Shells		
	2740	Shale-Lime		
	3365	Shale		
	3465	Shale-Lime		
	3480	Lime		
	3570	Shale-Lime		
	3790	Lime		
	3824	Conglomerate		
	3825	Lime		

RECEIVED
 STATE CORPORATION COMMISSION
 JAN 4 1963
 1-4-63
 CONSERVATION DIVISION
 Wichita, Kansas

STATE OF KANSAS)
) SS.
 COUNTY OF SEDGWICK)

The undersigned hereby certifies that to the best of his knowledge and belief, the above facts are true and correct.

C-G DRILLING CO.
 By J. F. Galloway
 J. F. Galloway

My commission expires: 3 day of December, 1950.
Vicky Jacobs
 Vicky Jacobs - Notary Public

