


Give All Information Completely
Make Required Affidavit
Mail or Deliver Report to:
Conservation Division
State Corporation Commission
211 No. Broadway
Wichita, Kansas

WELL PLUGGING RECORD

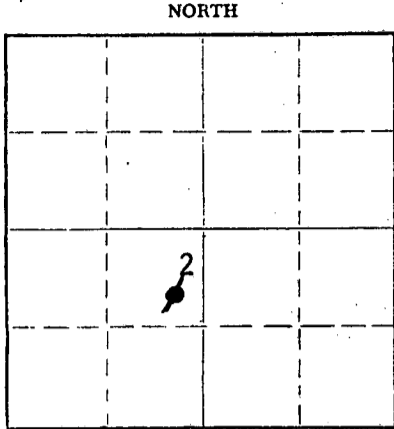

Locate well correctly on above Section Plat

Graham County. Sec. 21 Twp. 9S Rge. 21 (X) W (W)
Location as "NE/CNW/SW" or footage from lines SE 1/4 NE 1/4 SW 1/4
Lease Owner C-G Drilling Co.
Lease Name Benson Well No. 2
Office Address 107 Rule Building
Character of Well (completed as Oil, Gas or Dry Hole) Abandoned oil well
Date well completed Nov. 5 19 52
Application for plugging filed Nov 26 19 62
Application for plugging approved Nov 26 19 62
Plugging commenced Nov 26 19 62
Plugging completed Nov 26 19 62
Reason for abandonment of well or producing formation No longer commercial

If a producing well is abandoned, date of last production Feb 19 62
Was permission obtained from the Conservation Division or its agents before plugging was commenced? Yes

Name of Conservation Agent who supervised plugging of this well Eldon Petty
Producing formation Arbuckle Depth to top 3796 Bottom 3799 Total Depth of Well 3799 Feet
Show depth and thickness of all water, oil and gas formations.

OIL, GAS OR WATER RECORDS

CASING RECORD

FORMATION	CONTENT	FROM	TO	SIZE	PUT IN	PULLED OUT
				8-5/8"	153.77'	none
				5 1/2"	3796'	none

Describe in detail the manner in which the well was plugged, indicating where the mud fluid was placed and the method or methods used in introducing it into the hole. If cement or other plugs were used, state the character of same and depth placed, from _____ feet to _____ feet for each plug set.

Filled hole with heavy mud to 560'.
Filled to top with cement.

RECEIVED
STATE CORPORATION COMMISSION
JAN 2 1963
CONSERVATION DIVISION
Wichita, Kansas


1-2-63

(If additional description is necessary, use BACK of this sheet)
Name of Plugging Contractor Globe Oilwell Cementing Co.
Address Great Bend, Kansas

STATE OF Kansas, COUNTY OF Sedgwick, ss.
G. F. Galloway (Employee or owner) or (owner or operator) of the above-described well, being first duly sworn on oath, says: That I have knowledge of the facts, statements, and matters herein contained and the log of the above-described well as filed and that the same are true and correct. So help me God.

(Signature) G. F. Galloway
107 Rule Building, Wichita, Kansas
(Address)

Subscribed and sworn to before me this 3rd day of December, 19 62
My commission expires May 20, 1963

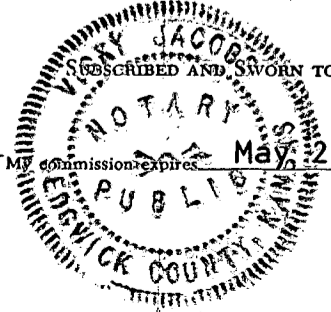

Vicky Jacobs
Notary Public.

15-065-03397-00-00

WELL LOG

OPERATOR C-G Drilling Co.

SEC. 21-9S-21W

WELL NAME BENSON #2

LOC. SE 1/4 NE 1/4 SW 1/4

TOTAL DEPTH 3799

COUNTY GRAHAM

COMM. Oct 26, 1952

COMP. Nov 26, 1962

STATE KANSAS

RIG NO.

ELEVATION 2265

CASING: 153.77' (5 jts.) 8-5/8" OD Csg.
3796' of 5-1/2" OD Csg (122 jts.)

PRODUCTION: Abandoned

All measurements taken from the top of rotary bushing.

FROM	TO	FORMATION	DEVIATION FROM VERTICAL	REMARKS:
153	725	Sand-Shale		
	760	Sand		
	820	Sand-Shale		
	965	Sand		
	1225	Shale-Sand-Shells		
	1465	Sand		
	1728	Red Bed		
	1770	Anhydrite		
	1810	Shale		
	3150	Lime-Shale		
	3450	Lime-Shale		
	3750	Lime		
	3799	Lime-Shale		#1 DST 3796-3799

RECEIVED
STATE CORPORATION COMMISSION

JAN 2 1963

1-2-63
CONSERVATION DIVISION
Wichita, Kansas

STATE OF KANSAS)
COUNTY OF SEDGWICK) SS.

The undersigned hereby certifies that to the best of his knowledge and belief, the above facts are true and correct.

C-G DRILLING CO.

By G. F. Galloway
G. F. Galloway

THIS 3rd day of December, 1962.

Vicky Jacobs
Vicky Jacobs - Notary Public

