


Give All Information Completely
 Make Required Affidavit
 Mail or Deliver Report to:
 Conservation Division
 State Corporation Commission
 800 Bitting Building
 Wichita, Kansas

FORMATION PLUGGING RECORD

Strike out upper line
 when reporting plug-
 ging off formations.

NORTH

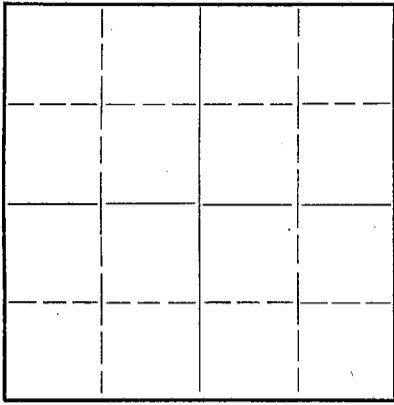

Locate well correctly on above
 Section Plat

Graham County, Sec. 10 Twp. 9 Rge. (E) 21 (W)
 Location as "NE $\frac{1}{4}$ NW $\frac{1}{4}$ SW $\frac{1}{4}$ " or footage from lines SE $\frac{1}{4}$ SE $\frac{1}{4}$ NE $\frac{1}{4}$
 Lease Owner Barnett Oil Company, et al
 Lease Name Desair Well No. 1
 Office Address 417 First Nat'l. Bank Bldg., Wichita, Kansas
 Character of Well (completed as Oil, Gas or Dry Hole) Dry Hole
 Date well completed May 31 19 50
 Application for plugging filed May 31 19 50
 Application for plugging approved May 31 19 50
 Plugging commenced May 31 19 50
 Plugging completed May 31 19 50
 Reason for abandonment of well or producing formation Dry Hole

If a producing well is abandoned, date of last production - 19 -
 Was permission obtained from the Conservation Division or its agents before plugging was com-
 menced? Yes

Name of Conservation Agent who supervised plugging of this well Eldon Petty
 Producing formation - Depth to top - Bottom - Total Depth of Well 3778 Feet
 Show depth and thickness of all water, oil and gas formations.

OIL, GAS OR WATER RECORDS

CASING RECORD

Formation	Content	From	To	Size	Put In	Pulled Out
<u>Surface Pipe</u>		<u>0</u>	<u>173 ft.</u>	<u>8 5/8"</u>	<u>173 ft.</u>	<u>None</u>

Describe in detail the manner in which the well was plugged, indicating where the mud fluid was placed and the method or methods used in introducing it into the hold. If cement or other plugs were used, state the character of same and depth placed, from - feet to - feet for each plug set.

Filled hole with heavy mud from 3778 ft. to 160 ft. Set wooden plug at 160 feet and filled with cement to 113 feet. Filled with heavy mud to 50 feet. Set wooden plug at 50 feet and filled with cement to bottom of cellar.

(If additional description is necessary, use BACK of this sheet)

Correspondence regarding this well should be addressed to Barnett Oil Company
 Address 417 First Nat'l. Bank Bldg., Wichita, Kansas

STATE OF Kansas, COUNTY OF Sedgwick, ss.
W. R. Hunter (employee of owner) or ~~Notary Public~~ of the above-described well,
 being first duly sworn on oath, says: That I have knowledge of the facts, statements, and matters herein contained and the log of the above-described well as filed and that the same are true and correct. So help me God.

(Signature) W. R. Hunter
417 First Nat'l. Bank Bldg., Wichita, Kansas
 (Address)

SUBSCRIBED AND SWORN to before me this 10th day of June, 1950
Edmund Oliver
 Notary Public.
 My commission expires May 12, 1951



PLUGGING
 FILE SEC 10 T 9 R 21
 BOOK PAGE 9 LINE 1

JUN 16 1950

6-14-50

BARNETT OIL COMPANY, ET AL
LOG OF DESAIR WELL NO. 1
SE 1/4 SE 1/4 NE 1/4 SECTION 10-9S-21W, GRAHAM COUNTY, KANSAS

DATE COMMENCED: May 17, 1950

DATE COMPLETED: May 31, 1950

<u>Formation</u>	<u>From</u>	<u>To</u>	<u>Remarks</u>
Surface Clay	0	75	
Sand	75	90	
Shale	90	100	
Shale and Shells	100	173	Set 8 5/8" Surface Pipe at 173 ft., cemented with 125 sacks.
Shale	173	620	
Shale and Shells	620	640	
Sand	640	730	
Shale, Shells and Sand	730	1150	
Sand	1150	1325	
Shale	1325	1350	
Shale and Shells	1350	1667	
Anhydrite	1667	1704	
Shale and Shells	1704	2300	
Shale and Lime	2300	2390	
Lime	2390	2550	
Shale and Lime	2550	3205	
Lime	3205	3360	
Lime and Shale	3360	3396	
Lime	3396	3615	
Lime and Shale	3615	3685	
Lime	3685	3704	
Lime, Shale and Chert	3704	3724	
Chert and Shale	3724	3770	
Lime and Shale	3770	3778	
Total Depth		3778	Dry and abandoned.

Certificate

I, W. R. Hunter, Office Manager of Barnett Oil Company, hereby certify that, to the best of my knowledge and belief, the above is a true and correct log of the Desair Well No. 1, located in the SE 1/4 SE 1/4 NE 1/4 of Section 10-9S-21W, Graham County, Kansas.

W. R. Hunter

Subscribed and sworn to before me, in and for the County of Sedgwick, State of Kansas, this 12th day of June, 1950.

Delade Oliver
Notary Public.

commission expires May 12, 1951.

PLUGGINS
FILE SEC 10-T-9-R-21W
BOOK PAGE 9 LINE 1