

STATE OF KANSAS  
STATE CORPORATION COMMISSION


Give All Information Completely  
Make Required Affidavit  
Mail or Deliver Report to:  
Conservation Division  
State Corporation Commission  
212 North Market, Insurance Bldg.  
Wichita, Kansas

WELL PLUGGING RECORD

15-065-20699-00-00

Graham County, Sec. 10 Twp. 9S Rge. 21W (XXXXXX)

Location as "NE/CNW/SW" or footage from lines E/2 NE SW  
Lease Owner Continental Oil Company  
Lease Name E. Clack Well No. 4  
Office Address 3535 NW 58th, Oklahoma City, Okla. 73112  
Character of Well (completed as Oil, Gas or Dry Hole) D & A  
Date well completed March 29 19 74  
Application for plugging filed " 19 74  
Application for plugging approved " 19 74  
Plugging commenced " 19 74  
Plugging completed 2:30 P.M. March 29 19 74  
Reason for abandonment of well or producing formation Dry Hole

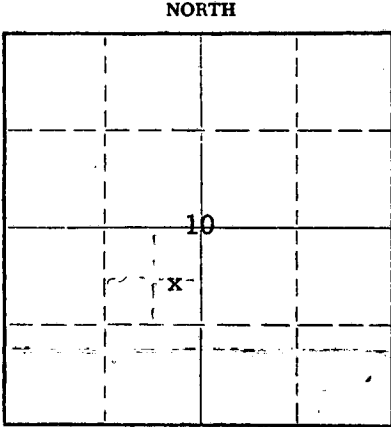

Locate well correctly on above Section Plat

If a producing well is abandoned, date of last production Yes 19       
Was permission obtained from the Conservation Division or its agents before plugging was commenced? yes

Name of Conservation Agent who supervised plugging of this well W. L. Nichols, Morland, Kansas  
Producing formation      Depth to top      Bottom      Total Depth of Well 3736 Feet  
Show depth and thickness of all water, oil and gas formations.

OIL, GAS OR WATER RECORDS

CASING RECORD

FORMATION	CONTENT	FROM	TO	SIZE	PUT IN	PULLED OUT
Arbuckle	Oil, Gas & Wtr	3690'	3714'	8 5/8"	246'	0

Describe in detail the manner in which the well was plugged, indicating where the mud fluid was placed and the method or methods used in introducing it into the hole. If cement or other plugs were used, state the character of same and depth placed, from      feet to      feet for each plug set.

~~Conditioned and filled hole with heavy mud.~~ Spotted cement plugs as follows:

Plug #1	3600-3200	70 sacks cement
Plug #2	850	70 sacks cement
Plug #3	250	20 sacks cement
Plug #4	40	10 sacks cement

Cut off surface pipe 3' below ground level and welded on identifying steel cap.

RECEIVED  
STATE CORPORATION COMMISSION  
APR 17 1974  
CONSERVATION DIVISION  
Wichita, Kansas  
4-17-74


(If additional description is necessary, use BACK of this sheet)

Name of Plugging Contractor John O. Farmer, Inc.  
Address Box 352, Russell, Kansas 67665

STATE OF Kansas, COUNTY OF Russell, ss.  
John O. Farmer (employee of owner) or (owner or operator) of the above-described

well, being first duly sworn on oath, says: That I have knowledge of the facts, statements, and matters herein contained and the log of the above-described well as filed and that the same are true and correct. So help me God.

(Signature) John O. Farmer President  
Box 352, Russell, Kansas 67665  
(Address)

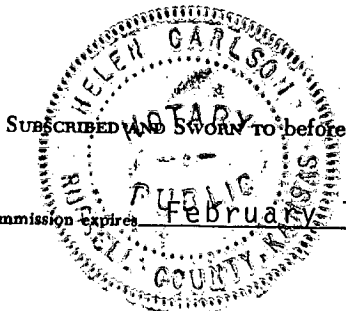

SUBSCRIBED AND SWORN to before me this 2nd day of April, 19 74

Helen Carlson  
Helen Carlson Notary Public.

DRILLERS LOG

15-065-20699-00-00

CLACK "E" #4

CASING RECORD:	OPERATOR:	Continental Oil Co.	DESCRIPTION:
245' w/8-5/8" Cemented w/175 sx.	CONTRACTOR:	John O. Farmer, Inc.	E/2 NE SW Sec. 10-9S-21W Graham County, Ks.
TOTAL DEPTH:	COMMENCED:	March 19, 1974	
3736'	COMPLETED:	March 29, 1974	

<u>FORMATION</u>	<u>FROM</u>	<u>TO</u>
Shale	248	800
Shale & Sand	800	1135
Shale	1135	1160
Sand	1160	1380
Red bed	1380	1663
Anhydrite	1663	1698
Shale & Shells	1698	2105
Shale & Lime	2105	2380
Lime & Shale	2380	2660
Shale & Lime	2660	2785
Lime & Shale	2785	2970
Shale & Lime Streaks	2970	3060
Shale & Lime	3060	3225
Lime & Shale	3225	3445
Lime	3445	3714
Arbuckle	3714	3736
Total Depth	3736'	

RECEIVED  
STATE CORPORATION COMMISSION

JUL 3 1974

CONSERVATION DIVISION  
Wichita, Kansas

7-3-74

I certify that this is a true and correct copy of the above log to the best of my knowledge.

JOHN O. FARMER, INC.

*John O. Farmer*  
John O. Farmer

Subscribed and sworn to before me this 2nd day of April, 1974.

*Helen Carlson*  
Helen Carlson

HELEN CARLSON  
NOTARY  
My commission expires:  
February 15, 1975  
Graham County, Kansas